

# **National Grid SA-COA** **PRODUCTION FILE**

**Contractor : ABB Contracting Co.**

**Project : SS 8709- 132/13.8kV in Alkha**

**Contract No : 11131113/00**

**Substation : 8709**

**Subject : 132Kv Busbar Protection Set-  
Relay Panel-2**

**ABB**




POWER SYSTEMS NETWORK MANAGEMENT  
PROTECTION AND SUBSTATION AUTOMATION SYSTEMS  
WBS NO: S-13656

ABB AUTOMATION COMPANY LTD.  
414, AL-KHARJ ROAD  
SECOND INDUSTRIAL CITY  
RIYADH-11383 K.S.A


CONTRACTOR : ABB Contracting Company  
CLIENT : National GridSA  
PROJECT : CONSTRUCTION OF NEW 132/13.8kV SS 8709 IN AL-KHARJ CITY  
SUBSTATION : S/S 8709  
CONTRACT NO. : 11131113/00  
TITLE : Assembly Drawing - +BBP1-2  
[132KV BUSBAR PROTECTION MAIN-1 BAY UNIT PANEL]

AS-BUILT BY _____ DATE _____			CONTRACT NO. 11131113/00		JOB ORDER NO. S-13656		COVER SHEET		الشركة الوطنية لنقل الكهرباء نقل الكهرباء National Grid sa					
01	13 49	FACTORY ASBUILT	DRAWN BY RIZ		CHECKED BY KVR		132KV BUSBAR PROTN.MAIN-1 BU PANEL +BBP1-2		INDEX	PLANT NO.	DRAWING NUMBER	SHEET NO.	REV. NO.	
00	13 04	FOR APPROVAL	DATE STARTED 24.01.2013		DATE COMPLETED		S/S 8709 - 132/13.8KV IN AL-KHARJ CITY		-	C421	CD-322992	SHT	CONT.	
REV. NO.	DATE	DESCRIPTION	OPRG. DEPT. CTPD		ENG. DEPT. AUT-PSAC		RIYADH SAUDI ARABIA					G00	G01	01

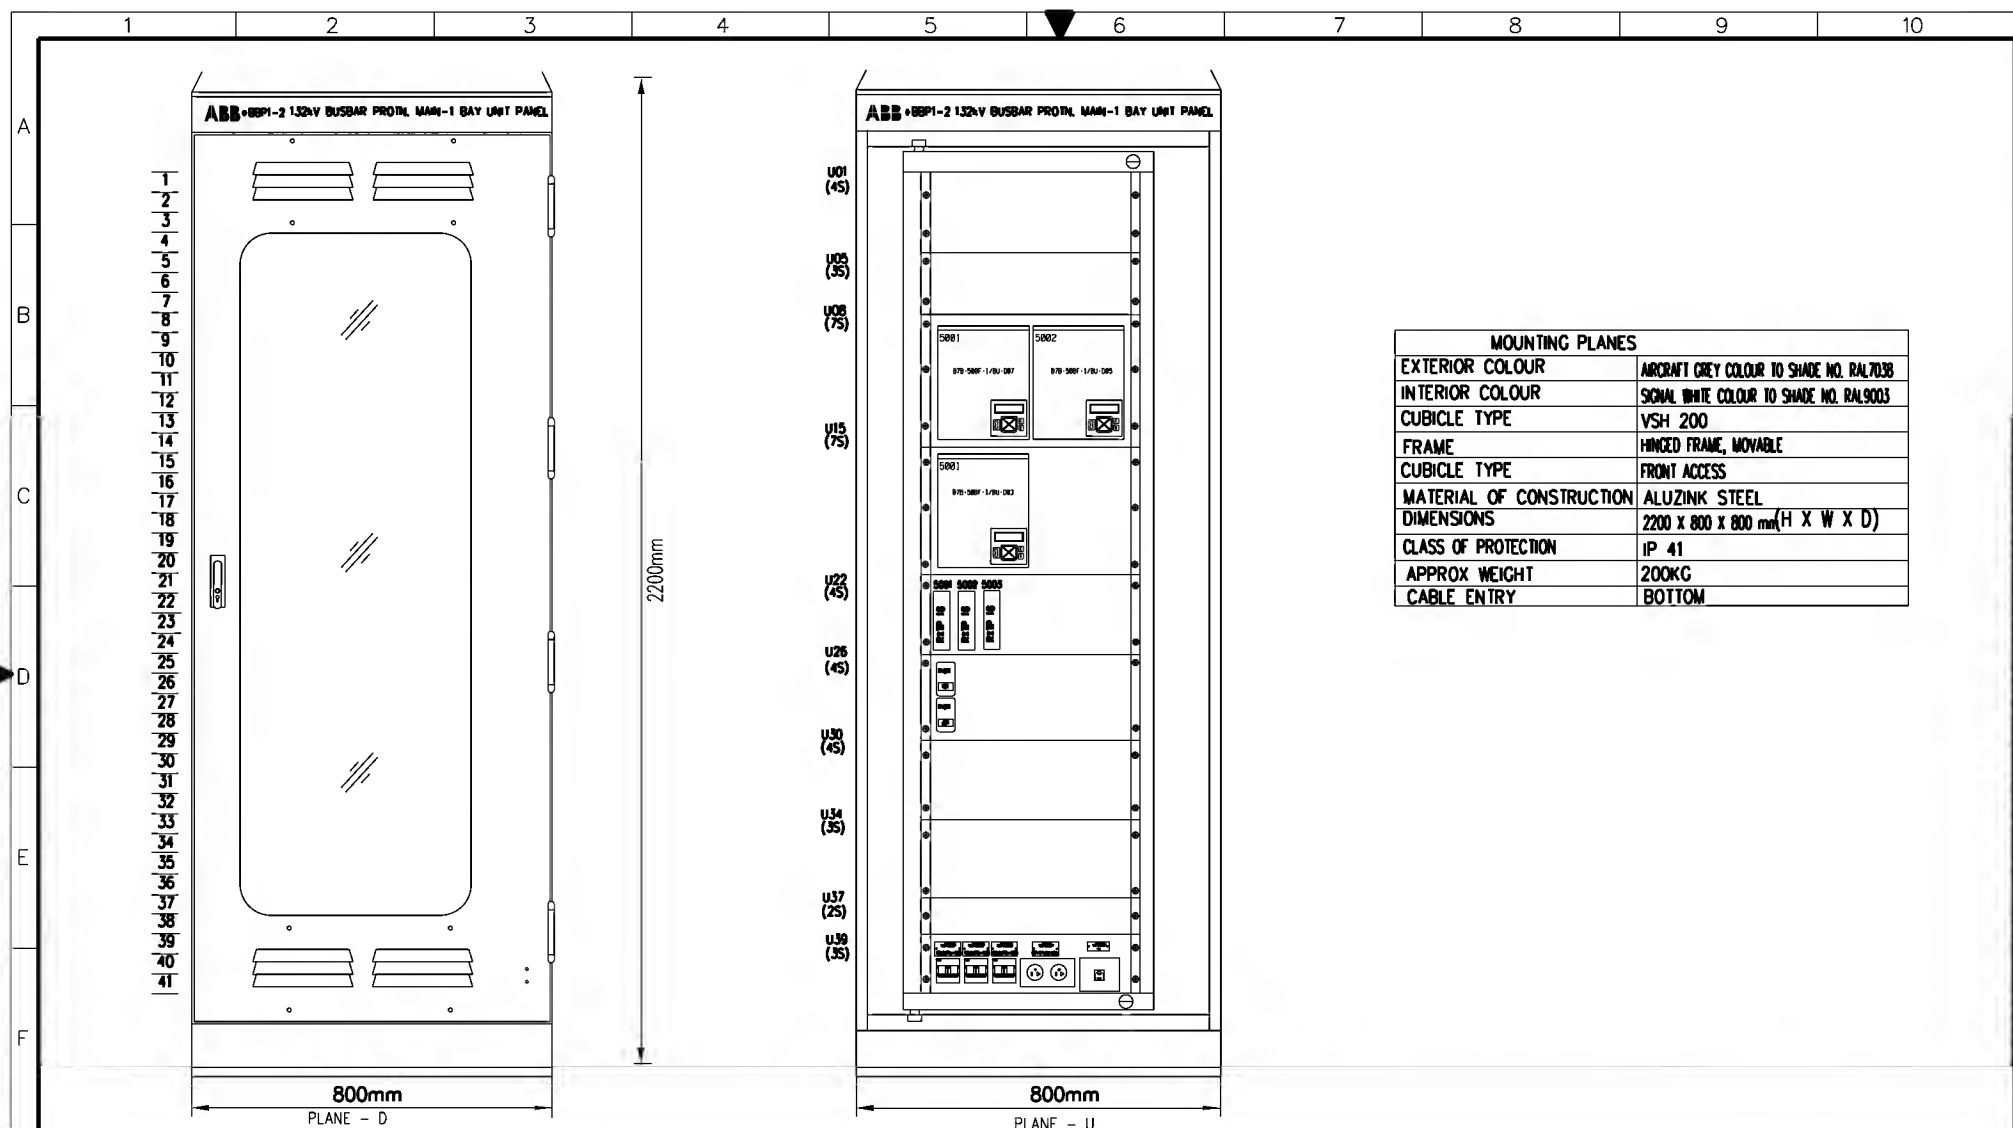

MOUNTING PLANES	
EXTERIOR COLOUR	AIRCRAFT GREY COLOUR TO SHADE NO. RAL7038
INTERIOR COLOUR	SIGNAL WHITE COLOUR TO SHADE NO. RAL9003
CUBICLE TYPE	VSH 200
FRAME	HINGED FRAME, MOVABLE
CUBICLE TYPE	FRONT ACCESS
MATERIAL OF CONSTRUCTION	ALUZINK STEEL
DIMENSIONS	2200 x 800 x 800 mm (H X W X D)
CLASS OF PROTECTION	IP 41
APPROX WEIGHT	200KG
CABLE ENTRY	BOTTOM

AS-BUILT BY _____ DATE _____		CONTRACT NO. <b>11131113/00</b>	JOB ORDER NO. <b>S-13656</b>	<b>ASSEMBLY DRAWING</b>		<b>نقل الكهرباء</b> الشركة الوطنية لنقل الكهرباء National Grid sa	
<b>01</b>	<b>13 49</b>	<b>FACTORY ASBUILT</b>		DRAWN BY <b>RIZ</b>	CHECKED BY <b>KVR</b>		
<b>00</b>	<b>13 04</b>	<b>FOR APPROVAL</b>		DATE STARTED <b>24.01.2013</b>	DATE COMPLETED _____	<b>132KV BUSBAR PROT. MAIN-1 BU PANEL +BBP1-2</b>	
REV. NO.	DATE	DESCRIPTION		PRG. DEPT. <b>CTPD</b>	ENG. DEPT. <b>AUT-PSAC</b>	<b>S/S 8709 - 132/13.8KV IN AL-KHARJ CITY</b>	
				<b>RIYADH</b>		<b>SAUDI ARABIA</b>	
						INDEX	PLANT NO.
						-	C421
						DRAWING NUMBER	
						CD-322992	
						SHEET NO.	REV. NO.
						SHT CONT.	01
						G01	G02

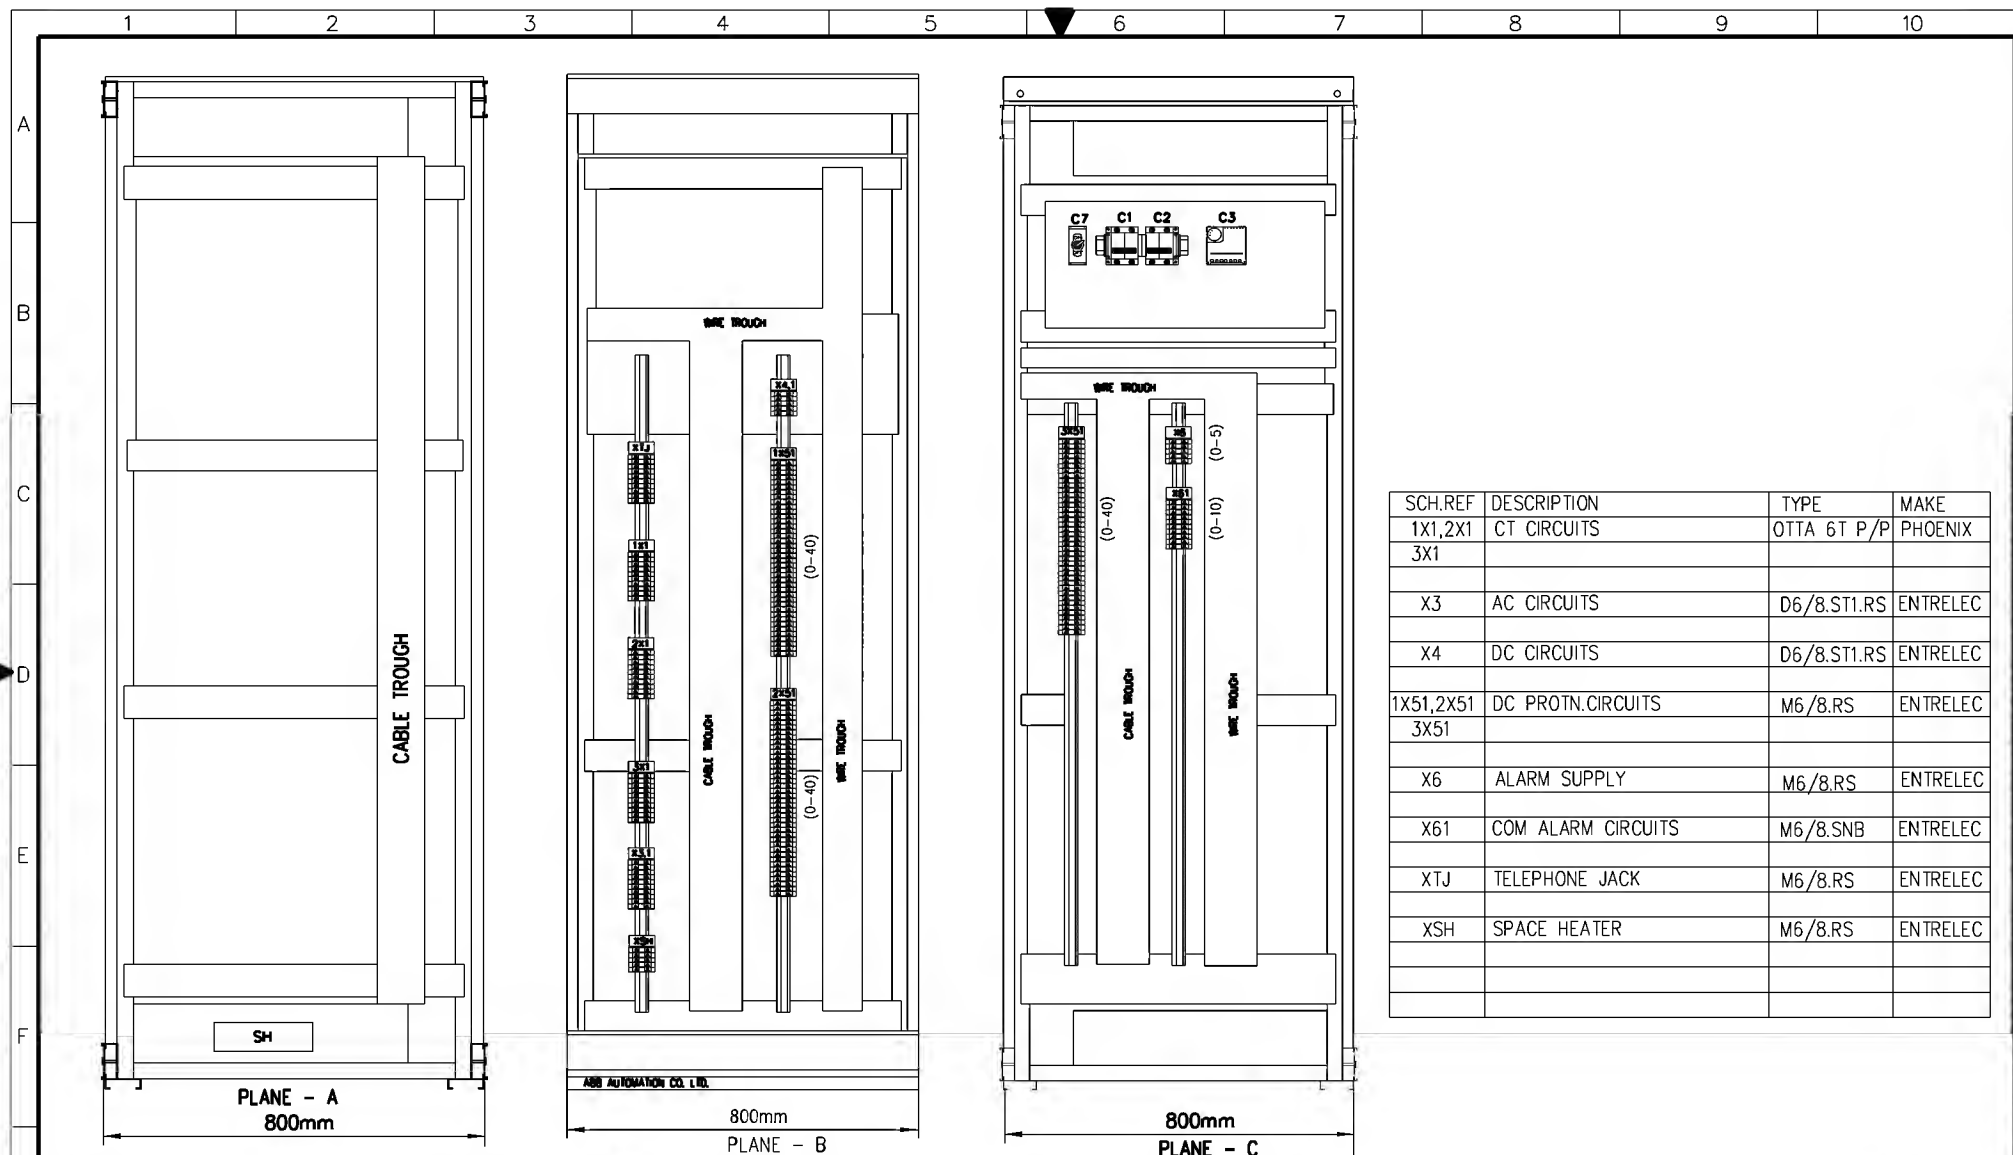

SCH.REF	DESCRIPTION	TYPE	MAKE
1X1,2X1 3X1	CT CIRCUITS	OTTA 6T P/P	PHOENIX
X3	AC CIRCUITS	D6/8.ST1.RS	ENTRELEC
X4	DC CIRCUITS	D6/8.ST1.RS	ENTRELEC
1X51,2X51 3X51	DC PROTN.CIRCUITS	M6/8.RS	ENTRELEC
X6	ALARM SUPPLY	M6/8.RS	ENTRELEC
X61	COM ALARM CIRCUITS	M6/8.SNB	ENTRELEC
XTJ	TELEPHONE JACK	M6/8.RS	ENTRELEC
XSH	SPACE HEATER	M6/8.RS	ENTRELEC



AS-BUILT BY \_\_\_\_\_ DATE \_\_\_\_\_ CONTRACT NO. **11131113/00** JOB ORDER NO. **S-13656**

01	13 49	FACTORY ASBUILT
00	13 04	FOR APPROVAL
REV. NO.	DATE	DESCRIPTION








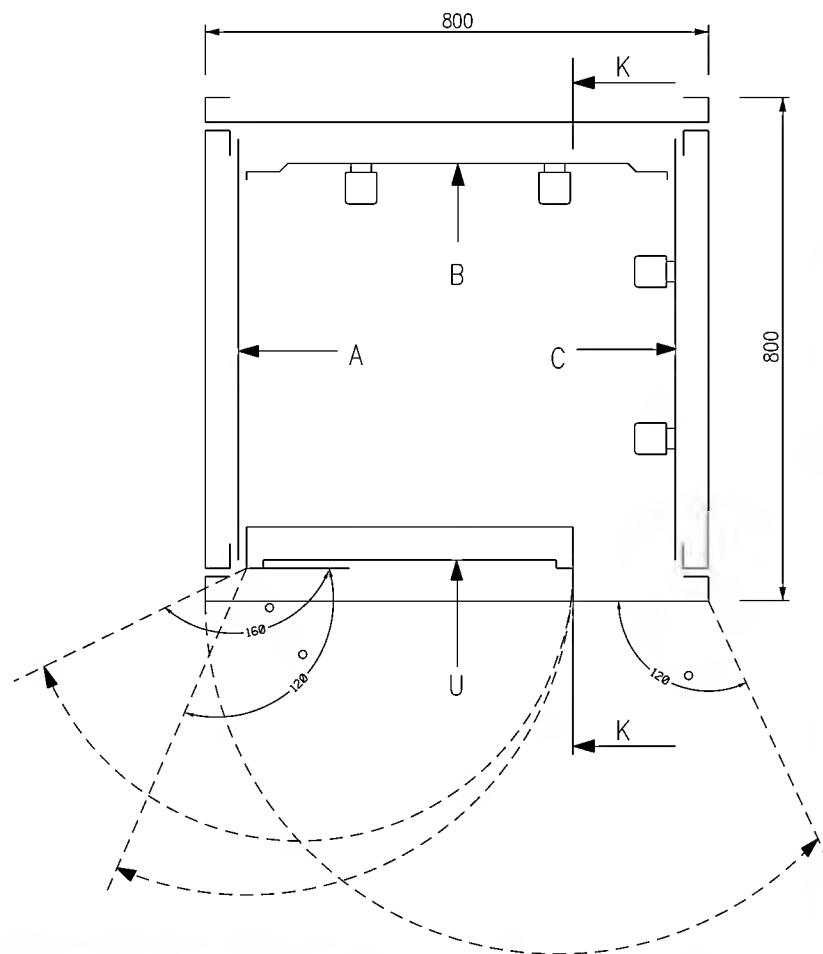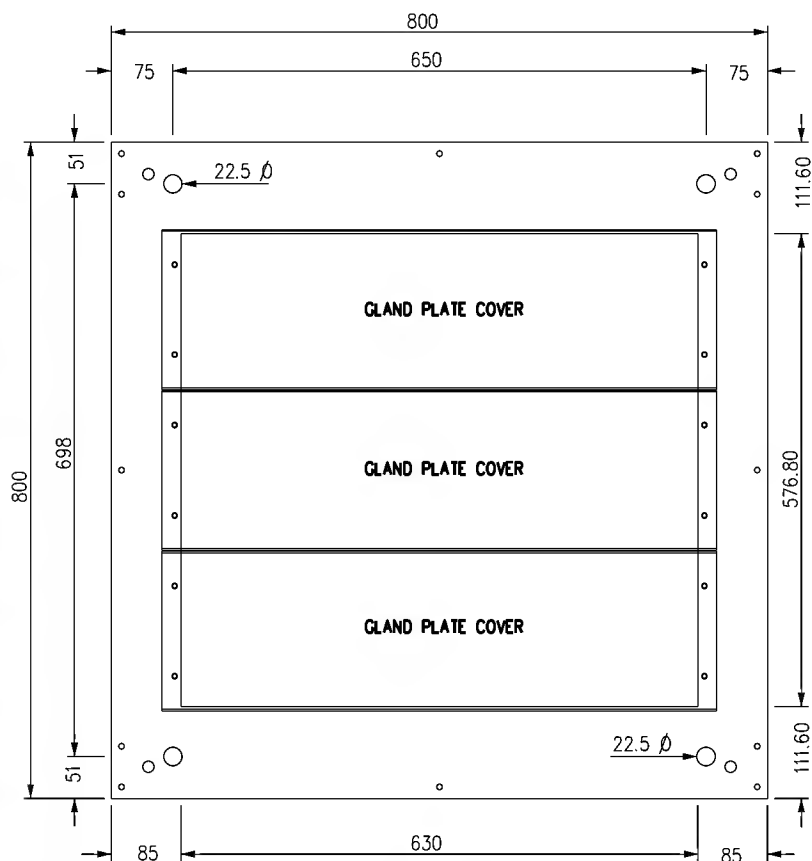



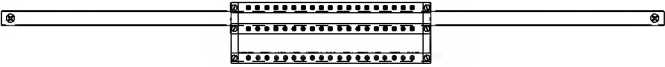

DRAWN BY **RIZ** CHECKED BY **KVR**  
 DATE STARTED **24.01.2013** DATE COMPLETED \_\_\_\_\_  
 PRG. DEPT. **CTPD** ENG. DEPT. **AUT-PSAC**

**ASSEMBLY DRAWING**  
**132KV BUSBAR PROTN.MAIN-1 BU PANEL +8BP1-2**  
**S/S 8709 - 132/13.8KV IN AL-KHARJ CITY**  
**RIYADH SAUDI ARABIA**

الشركة الوطنية لنقل الكهرباء					نقل الكهرباء National Grid SA	
INDEX	PLANT NO.	DRAWING NUMBER		SHEET NO.	REV. NO.	
-	C421	CD-322992		SHT CONT. G02 G03	01	



AS-BUILT BY _____ DATE _____			CONTRACT NO. 11131113/00		JOB ORDER NO. S-13656		ASSEMBLY DRAWING				نقل الكهرباء الشركة الوطنية لنقل الكهرباء National Grid sa			
DRAWN BY RIZ CHECKED BY KVR			132KV BUSBAR PROTN.MAIN-1 BU PANEL +BBP1-2				INDEX PLANT NO. DRAWING NUMBER SHEET NO. REV. NO.							
DATE STARTED 24.01.2013 DATE COMPLETED _____			S/S 8709 - 132/13.8KV IN AL-KHARJ CITY				- C421 CD-322992 G03 G04 01							
OPRG. DEPT. CTPD ENG. DEPT. AUT-PSAC			RIYADH SAUDI ARABIA											
FOR APPROVAL														
REVISION NO. DATE DESCRIPTION														

	1	2	3	4	5	6	7	8	9	10								
A																		
B																		
C	<p style="text-align: center;"><b>TOP VIEW FOR EARTHING BAR</b></p>																	
D	<p><b>U PLANE TOP LABEL</b></p> <table border="1"> <tr> <td colspan="2">+BBP1.2 132kV BUSBAR PROTECTION MAIN-1 BAY UNIT PANEL</td> <td rowspan="2">28</td> </tr> <tr> <td colspan="2">   </td> </tr> <tr> <td colspan="2">800</td> <td></td> </tr> </table>										+BBP1.2 132kV BUSBAR PROTECTION MAIN-1 BAY UNIT PANEL		28	 		800		
+BBP1.2 132kV BUSBAR PROTECTION MAIN-1 BAY UNIT PANEL		28																
 																		
800																		
E	<p><b>U PLANE BOTTOM LABEL</b></p> <table border="1"> <tr> <td colspan="2">   </td> <td rowspan="2">28</td> </tr> <tr> <td colspan="2">ABB AUTOMATION CO. LTD</td> </tr> <tr> <td colspan="2">800</td> <td></td> </tr> </table>										 		28	ABB AUTOMATION CO. LTD		800		
 		28																
ABB AUTOMATION CO. LTD																		
800																		
F																		

**MANUFACTURING LABEL**

<b>ABB</b> ABB Automation Co.Ltd.	
PROJECT :	National Grid SA S/S 8709
ORDER REFERENCE :	2875 RF S13656
YEAR OF MANUFACTURE:	2013
PANEL NO. :	+BBP1.2
DRAWING NO. :	S13656-CD-322993
MADE IN THE KINGDOM OF SAUDI ARABIA	

AS-BUILT BY _____ DATE _____			CONTRACT NO. 11131113/00		JOB ORDER NO. S-13656		<b>ASSEMBLY DRAWING</b>		الشركة الوطنية لنقل الكهرباء		نقل الكهرباء	
DRAWN BY <b>RIZ</b> CHECKED BY <b>KVR</b>			DATE STARTED <b>24.01.2013</b> DATE COMPLETED _____		132KV BUSBAR PROTN.MAIN-1 BU PANEL +BBP1-2		S/S 8709 - 132/13.8KV IN AL-KHARJ CITY		INDEX		PLANT NO.	
PRG. DEPT. <b>CTPD</b> ENG. DEPT. <b>AUT-PSAC</b>			SAUDI ARABIA		- C421		CD-322992		SHEET NO.		REV. NO.	
REV. NO.			DATE		DESCRIPTION		FACTORY ASBUILT FOR APPROVAL		G04		L00	



POWER SYSTEMS NETWORK MANAGEMENT  
PROTECTION AND SUBSTATION AUTOMATION SYSTEMS  
WBS NO: S-13656

ABB AUTOMATION COMPANY LTD  
414, AL-KHARJ ROAD  
SECOND INDUSTRIAL CITY  
RIYADH-11383 K.S.A

CONTRACTOR : ABB Contracting Company  
CLIENT : National Gridsa  
PROJECT : CONSTRUCTION OF NEW 132/13.8kV SS 8709 IN AL-KHARJ CITY  
SUBSTATION : S/S 8709  
CONTRACT NO. : 11131113/00  
TITLE : LIST OF APPARATUS – +BBP1-2  
[132KV BUSBAR PROTECTION MAIN-1 BAY UNIT PANEL]

AS-BUILT BY _____ DATE _____		CONTRACT NO. 11131113/00	JOB ORDER NO. S-13656	COVER SHEET		الشركة الوطنية لنقل الكهرباء		نقل الكهرباء	
01	13 49	FACTORY ASBUILT	DRAWN BY RIZ	CHECKED BY KVR	132KV BUSBAR PROTN.MAIN-1 BU PANEL +BBP1-2	National Grid sa			
00	13 04	FOR APPROVAL	DATE STARTED 24.01.2013	DATE COMPLETED	S/S 8709 - 132/13.8KV IN AL-KHARJ CITY	INDEX	PLANT NO.	DRAWING NUMBER	SHEET NO.
REV. NO.	DATE	DESCRIPTION	OPRG. DEPT. CTPD	ENG. DEPT. AUT-PSAC	RIYADH SAUDI ARABIA	-	C421	CD-322992	L00L01
									01

	2	3	4	5	6	7	8	9	10
--	---	---	---	---	---	---	---	---	----

[illegible]


AS-BUILT By _____ DATE _____			CONTRACT NO. 11131113/00		JOB ORDER NO. S-13656		LIST OF APPARATUS				نقل الكهرباء الشركة الوطنية لنقل الكهرباء National Grid sa							
			DRAWN BY RIZ CHECKED BY KVR		132KV BUSBAR PROTN.MAIN-1 BU PANEL +BBP1-2				INDEX		PLANT NO.		DRAWING NUMBER		SHEET NO.		REV. NO.	
01 13 49 FACTORY ASBUILT			DATE STARTED 24.01.2013 DATE COMPLETED		S/S 8709 - 132/13.8KV IN AL-KHARJ CITY										SHT CONT.			
00 13 04 FOR APPROVAL			OPRG. DEPT. CTPO ENG. DEPT. AUT-PSAC		RIYADH SAUDI ARABIA				-		C421		CD-322992		01 02		01	
REV. NO. DATE DESCRIPTION																		





	2	3	4	5		6	7	8	9	10
--	---	---	---	---	---	---	---	---	---	----

[illegible]

AS-BUILT BY _____ DATE _____			CONTRACT NO. <b>11131113/00</b>		JOB ORDER NO. <b>S-13656</b>		<b>LIST OF APPARATUS</b> <b>132KV BUSBAR PROT.N.MAIN-1 BU PANEL +B8P1-2</b> <b>S/S 8709 - 132/13.8KV IN AL-KHARJ CITY</b> <b>RIYADH SAUDI ARABIA</b>			<b>نقل الكهرباء</b> <b>الشركة الوطنية لنقل الكهرباء</b>  <b>National Grid SA</b>				
<b>01 13 49</b> <b>00 13 04</b> <b>FACTORY ASBUILT</b> <b>FOR APPROVAL</b>			DRAWN BY <b>RIZ</b> CHECKED BY <b>KVR</b> DATE STARTED <b>24.01.2013</b> DATE COMPLETED _____ OPRG. DEPT. <b>CTPD</b> ENG. DEPT. <b>AUT-PSAC</b>					INDEX PLANT NO. DRAWING NUMBER SHEET NO. REV. NO. <b>- C421 CD-322992 103104 01</b>						



LABEL REF.	LABEL ENGRAVING	MATERIALS	ENGRAVING	LABEL SIZE	LETTER SIZE
U08.5001	U08.5001 878+508F-1/BU-D07	TRAFOLITE	BLACK LETTERS ON WHITE BACKGROUND	50X15mm	4mm
U08.5002	U08.5002 878+508F-1/BU-D05	TRAFOLITE	BLACK LETTERS ON WHITE BACKGROUND	50X15mm	4mm
U15.5001	U15.5001 878+508F-1/BU-D03	TRAFOLITE	BLACK LETTERS ON WHITE BACKGROUND	50X15mm	4mm
U22.5001	U22.5001 IS-1	ALUMINUM PAPER FOIL	BLACK LETTERS	50X10mm	3mm
U22.5002	U22.5002 IS-2	ALUMINUM PAPER FOIL	BLACK LETTERS	50X10mm	3mm
U22.5003	U22.5003 IS-3	ALUMINUM PAPER FOIL	BLACK LETTERS	50X10mm	3mm
U26.101	U26.101 748F-1/D07	ALUMINUM PAPER FOIL	BLACK LETTERS	50X10mm	3mm
U26.301	U26.301 748F-1/D03	ALUMINUM PAPER FOIL	BLACK LETTERS	50X10mm	3mm
U37.5001	U37.5001 DC SUPPLY MCB FOR D07	TRAFOLITE	BLACK LETTERS ON WHITE BACKGROUND	50X15mm	4mm
U37.5002	U37.5002 DC SUPPLY MCB FOR D05	TRAFOLITE	BLACK LETTERS ON WHITE BACKGROUND	50X15mm	4mm
U37.5003	U37.5003 DC SUPPLY MCB FOR D03	TRAFOLITE	BLACK LETTERS ON WHITE BACKGROUND	50X15mm	4mm
U37.5004	U37.5004 C01-127V,C02-220V	TRAFOLITE	BLACK LETTERS ON WHITE BACKGROUND	50X15mm	4mm
U37.5005	U37.5005 UJ	TRAFOLITE	BLACK LETTERS ON WHITE BACKGROUND	50X15mm	4mm

AS-BUILT BY _____ DATE _____			CONTRACT NO. <b>1113113/00</b>		JOB ORDER NO. <b>S-13656</b>		<b>LIST OF APPARATUS</b>		نقل الكهرباء الشركة الوطنية لنقل الكهرباء National Grid sa	
01 13 49 00 13 04 FACTORY ASBUILT FOR APPROVAL			DRAWN BY <b>RIZ</b> CHECKED BY <b>KVR</b> DATE STARTED <b>24.01.2013</b> DATE COMPLETED _____ OPRG. DEPT. <b>CTPD</b> ENG. DEPT. <b>AUT-PSAC</b>		<b>132KV BUSBAR PROTN.MAIN-1 BU PANEL +8BP1-2</b> <b>S/S 8709 - 132/13.8KV IN AL-KHARJ CITY</b> <b>RIYADH SAUDI ARABIA</b>			INDEX PLANT NO. DRAWING NUMBER SHEET NO. REV. NO. - C421 CD-322992 L06 L07 01		

	1	2	3	4	5	6	7	8	9	10
A										
B										
C										
D										
E										
F										
G										

LABEL REF.	LABEL ENGRAVING	MATERIALS	ENGRAVING	LABEL SIZE	LETTER SIZE
C1	C1 127V AC SUPPLY MCB	TRAFOLITE	BLACK LETTERS ON WHITE BACKGROUND	50X15mm	4mm
C2	C2 220V AC SUPPLY MCB	TRAFOLITE	BLACK LETTERS ON WHITE BACKGROUND	50X15mm	4mm
C3	C3 THERMOSTAT	TRAFOLITE	BLACK LETTERS ON WHITE BACKGROUND	50X15mm	4mm
C7	C7 ON/OFF SWITCH	TRAFOLITE	BLACK LETTERS ON WHITE BACKGROUND	50X15mm	4mm
DS	DS DOOR SWITCH	TRAFOLITE	BLACK LETTERS ON WHITE BACKGROUND	50X15mm	4mm
IL	IL ILLUMINATION LAMP	TRAFOLITE	BLACK LETTERS ON WHITE BACKGROUND	50X15mm	4mm
SH	SH SPACE HEATER	TRAFOLITE	BLACK LETTERS ON WHITE BACKGROUND	50X15mm	4mm

AS-BUILT BY _____ DATE _____		CONTRACT NO. 11131113/00	JOB ORDER NO. S-13656	LIST OF APPARATUS		الشركة الوطنية لنقل الكهرباء		نقل الكهرباء	
01	13 49	FACTORY ASBUILT	DRAWN BY RIZ CHECKED BY KVR	132KV BUSBAR PROTN.MAIN-1 BU PANEL +8BP1-2		National Grid sa			
00	13 04	FOR APPROVAL	DATE STARTED 24.01.2013 DATE COMPLETED _____	S/S 8709 - 132/13.8KV IN AL-KHARJ CITY		INDEX	PLANT NO.	DRAWING NUMBER	SHEET NO.
REV. NO.	DATE	DESCRIPTION	OPRG. DEPT. CTPD ENG. DEPT. AUT-PSAC	RIYADH SAUDI ARABIA		-	C421	CD-322992	01

THIS DRAWING AND THE INFORMATION CONTAINED HEREIN ARE THE SOLE PROPERTY OF NATIONAL GRID SA. NO REPRODUCTION OR TRANSMISSION IN ANY FORM OR BY ANY MEANS, WITHOUT THE WRITTEN CONSENT OF ITS OWNER.



POWER SYSTEMS NETWORK MANAGEMENT  
PROTECTION AND SUBSTATION AUTOMATION SYSTEMS  
WBS NO: S-13656

ABB AUTOMATION COMPANY LTD.  
414, AL-KHARJ ROAD  
SECOND INDUSTRIAL CITY  
RIYADH-11383 K.S.A

CONTRACTOR : ABB Contracting Company  
CLIENT : National Gridsa  
PROJECT : CONSTRUCTION OF NEW 132/13.8kv SS 8709 IN AL-KHARJ CITY  
SUBSTATION : S/S 8709  
CONTRACT NO. : 11131113/00  
TITLE : SCHEMATICS DRAWINGS - +BBP1-2  
[132KV BUSBAR PROTECTION MAIN-1 BAY UNIT PANEL]

AS-BUILT BY _____ DATE _____		CONTRACT NO. <b>11131113/00</b>	JOB ORDER NO. <b>S-13656</b>	<b>COVER SHEET</b>		<b>الشركة الوطنية لنقل الكهرباء</b> National Grid sa				
<b>01</b>	<b>13 49</b>	<b>FACTORY ASBUILT</b>	DRAWN BY <b>RIZ</b>	CHECKED BY <b>KVR</b>	<b>132KV BUSBAR PROTN.MAIN-1 BU PANEL +BBP1-2</b>	INDEX	PLANT NO.	DRAWING NUMBER	SHEET NO.	REV. NO.
<b>00</b>	<b>13 04</b>	<b>FOR APPROVAL</b>	DATE STARTED <b>24.01.2013</b> DATE COMPLETED _____		<b>S/S 8709 - 132/13.8KV IN AL-KHARJ CITY</b>				<b>SHT CONT.</b>	
REV. NO.	DATE	DESCRIPTION	OPRG. DEPT. <b>CTPD</b> ENG. DEPT. <b>AUT-PSAC</b>		<b>RIYADH</b>	<b>-</b>	<b>C421</b>	<b>CD-322993</b>	<b>000 001</b>	<b>01</b>



1	2	3	4	5	6	7	8	9	10																																																																																																																		
A																																																																																																																											
B																																																																																																																											
C																																																																																																																											
D																																																																																																																											
E																																																																																																																											
F																																																																																																																											
<table><tr><th>SYMBOL</th><th>DESCRIPTION</th><th>SYMBOL</th><th>DESCRIPTION</th><th>SYMBOL</th><th>DESCRIPTION</th></tr><tr><td></td><td>FRAME CONNECTION</td><td></td><td>MAIN CONTACT OF A CIRCUIT BREAKER PASSING MAKE CONTACT CLOSING MOMENTARILY DURING OPERATION AND RELEASE</td><td></td><td>RELAY WITH TWO MAKE CONTACTS, ONE OF THEM DELAYED WHEN OPERATING</td></tr><tr><td></td><td>EARTH CONNECTION</td><td></td><td>BREAK CONTACT DELAYED WHEN OPERATING</td><td></td><td>RELAY WITH TWO ACTUATORS AND A TWO STABLE POSITIONS</td></tr><tr><td></td><td>RESISTOR</td><td></td><td>MAKE CONTACT DELAYED WHEN RELEASING</td><td></td><td>SIGNALLING LAMP</td></tr><tr><td></td><td>VARIABLE RESISTOR</td><td></td><td>TWO MECHANICAL LINKS CROSSING WITHOUT CONNECTION</td><td></td><td>MECHANICAL INDICATOR WITH AUTOMATIC RESET</td></tr><tr><td></td><td>RESISTOR WITH PRESET ADJUSTMENT</td><td></td><td>JUNCTION OF MECHANICAL LINKS</td><td></td><td>MECHANICAL INDICATOR WITH NON-AUTOMATIC RESET</td></tr><tr><td></td><td>CAPACITOR</td><td></td><td>AUTOMATIC RESET</td><td></td><td>ELECTRICALLY CONTROLLED MECHANICAL INDICATOR WITH AUTOMATIC RESET</td></tr><tr><td></td><td>SEMICONDUCTOR DIODE USED AS A CAPACITIVE DEVICE</td><td></td><td>NON-AUTOMATIC RESET</td><td></td><td>ELECTRICALLY CONTROLLED MECHANICAL INDICATOR WITH NON-AUTOMATIC RESET</td></tr><tr><td></td><td>OPEN CONTACT, MAKE CONTACT</td><td></td><td>SWITCHING DEVICE WITH MANUAL OPERATION AND WITH AUTOMATIC RESET</td><td></td><td>RELAY WITH MAKE CONTACT</td></tr><tr><td></td><td>CLOSED CONTACT, BREAK CONTACT</td><td></td><td>SWITCHING DEVICE WITH MANUAL OPERATION AND WITH NON-AUTOMATIC RESET</td><td></td><td>RELAY WITH CHANGE-OVER CONTACT</td></tr><tr><td></td><td>CHANGE-OVER CONTACT, BREAK BEFORE MAKE</td><td></td><td>CHANGE-OVER SWITCHING DEVICE WITH MANUAL CONTROL</td><td></td><td>RELAY WITH MAKE CONTACT, DELAYED WHEN OPERATING</td></tr><tr><td></td><td>MAKE CONTACT WHICH IS EARLY WHEN OPERATING AND LATE WHEN RELEASING</td><td></td><td>CONTROL AUTOMATIC RESET FROM POSITION 1-2 TO THE NEUTRAL POSITION</td><td></td><td>RELAY WITH MAKE CONTACT, DELAYED WHEN RELEASING</td></tr><tr><td></td><td>BREAK CONTACT WHICH IS LATE WHEN OPERATING AND EARLY WHEN RELEASING</td><td></td><td>RELAY WITH MAKE CONTACT, DELAYED WHEN OPERATING AND RELEASING</td><td></td><td>ELECTRO-MECHANICAL POSITION INDICATOR WITH ONE DE-ENERGIZED AND ONE OPERATED POSITION</td></tr><tr><td></td><td>SWITCHING DEVICE WITH MANUAL CONTROL</td><td></td><td></td><td></td><td>ELECTRO-MECHANICAL POSITION INDICATOR WITH ONE DE-ENERGIZED AND TWO OPERATED POSITION</td></tr><tr><td></td><td>MAKE CONTACT DELAYED WHEN OPERATING</td><td></td><td></td><td></td><td>BELL, BUZZER</td></tr><tr><td></td><td>BREAK CONTACT DELAYED WHEN RELEASING</td><td></td><td></td><td></td><td>SIREN , HORN</td></tr><tr><td></td><td>MAKE CONTACT DELAYED WHEN OPERATING AND RELEASING</td><td></td><td></td><td></td><td></td></tr><tr><td></td><td>MAIN CONTACT OF A SWITCH DISCONNECTOR</td><td></td><td></td><td></td><td></td></tr><tr><td></td><td>MAIN CONTACT OF A DISCONNECTOR</td><td></td><td></td><td></td><td></td></tr></table>										SYMBOL	DESCRIPTION	SYMBOL	DESCRIPTION	SYMBOL	DESCRIPTION		FRAME CONNECTION		MAIN CONTACT OF A CIRCUIT BREAKER PASSING MAKE CONTACT CLOSING MOMENTARILY DURING OPERATION AND RELEASE		RELAY WITH TWO MAKE CONTACTS, ONE OF THEM DELAYED WHEN OPERATING		EARTH CONNECTION		BREAK CONTACT DELAYED WHEN OPERATING		RELAY WITH TWO ACTUATORS AND A TWO STABLE POSITIONS		RESISTOR		MAKE CONTACT DELAYED WHEN RELEASING		SIGNALLING LAMP		VARIABLE RESISTOR		TWO MECHANICAL LINKS CROSSING WITHOUT CONNECTION		MECHANICAL INDICATOR WITH AUTOMATIC RESET		RESISTOR WITH PRESET ADJUSTMENT		JUNCTION OF MECHANICAL LINKS		MECHANICAL INDICATOR WITH NON-AUTOMATIC RESET		CAPACITOR		AUTOMATIC RESET		ELECTRICALLY CONTROLLED MECHANICAL INDICATOR WITH AUTOMATIC RESET		SEMICONDUCTOR DIODE USED AS A CAPACITIVE DEVICE		NON-AUTOMATIC RESET		ELECTRICALLY CONTROLLED MECHANICAL INDICATOR WITH NON-AUTOMATIC RESET		OPEN CONTACT, MAKE CONTACT		SWITCHING DEVICE WITH MANUAL OPERATION AND WITH AUTOMATIC RESET		RELAY WITH MAKE CONTACT		CLOSED CONTACT, BREAK CONTACT		SWITCHING DEVICE WITH MANUAL OPERATION AND WITH NON-AUTOMATIC RESET		RELAY WITH CHANGE-OVER CONTACT		CHANGE-OVER CONTACT, BREAK BEFORE MAKE		CHANGE-OVER SWITCHING DEVICE WITH MANUAL CONTROL		RELAY WITH MAKE CONTACT, DELAYED WHEN OPERATING		MAKE CONTACT WHICH IS EARLY WHEN OPERATING AND LATE WHEN RELEASING		CONTROL AUTOMATIC RESET FROM POSITION 1-2 TO THE NEUTRAL POSITION		RELAY WITH MAKE CONTACT, DELAYED WHEN RELEASING		BREAK CONTACT WHICH IS LATE WHEN OPERATING AND EARLY WHEN RELEASING		RELAY WITH MAKE CONTACT, DELAYED WHEN OPERATING AND RELEASING		ELECTRO-MECHANICAL POSITION INDICATOR WITH ONE DE-ENERGIZED AND ONE OPERATED POSITION		SWITCHING DEVICE WITH MANUAL CONTROL				ELECTRO-MECHANICAL POSITION INDICATOR WITH ONE DE-ENERGIZED AND TWO OPERATED POSITION		MAKE CONTACT DELAYED WHEN OPERATING				BELL, BUZZER		BREAK CONTACT DELAYED WHEN RELEASING				SIREN , HORN		MAKE CONTACT DELAYED WHEN OPERATING AND RELEASING						MAIN CONTACT OF A SWITCH DISCONNECTOR						MAIN CONTACT OF A DISCONNECTOR				
SYMBOL	DESCRIPTION	SYMBOL	DESCRIPTION	SYMBOL	DESCRIPTION																																																																																																																						
	FRAME CONNECTION		MAIN CONTACT OF A CIRCUIT BREAKER PASSING MAKE CONTACT CLOSING MOMENTARILY DURING OPERATION AND RELEASE		RELAY WITH TWO MAKE CONTACTS, ONE OF THEM DELAYED WHEN OPERATING																																																																																																																						
	EARTH CONNECTION		BREAK CONTACT DELAYED WHEN OPERATING		RELAY WITH TWO ACTUATORS AND A TWO STABLE POSITIONS																																																																																																																						
	RESISTOR		MAKE CONTACT DELAYED WHEN RELEASING		SIGNALLING LAMP																																																																																																																						
	VARIABLE RESISTOR		TWO MECHANICAL LINKS CROSSING WITHOUT CONNECTION		MECHANICAL INDICATOR WITH AUTOMATIC RESET																																																																																																																						
	RESISTOR WITH PRESET ADJUSTMENT		JUNCTION OF MECHANICAL LINKS		MECHANICAL INDICATOR WITH NON-AUTOMATIC RESET																																																																																																																						
	CAPACITOR		AUTOMATIC RESET		ELECTRICALLY CONTROLLED MECHANICAL INDICATOR WITH AUTOMATIC RESET																																																																																																																						
	SEMICONDUCTOR DIODE USED AS A CAPACITIVE DEVICE		NON-AUTOMATIC RESET		ELECTRICALLY CONTROLLED MECHANICAL INDICATOR WITH NON-AUTOMATIC RESET																																																																																																																						
	OPEN CONTACT, MAKE CONTACT		SWITCHING DEVICE WITH MANUAL OPERATION AND WITH AUTOMATIC RESET		RELAY WITH MAKE CONTACT																																																																																																																						
	CLOSED CONTACT, BREAK CONTACT		SWITCHING DEVICE WITH MANUAL OPERATION AND WITH NON-AUTOMATIC RESET		RELAY WITH CHANGE-OVER CONTACT																																																																																																																						
	CHANGE-OVER CONTACT, BREAK BEFORE MAKE		CHANGE-OVER SWITCHING DEVICE WITH MANUAL CONTROL		RELAY WITH MAKE CONTACT, DELAYED WHEN OPERATING																																																																																																																						
	MAKE CONTACT WHICH IS EARLY WHEN OPERATING AND LATE WHEN RELEASING		CONTROL AUTOMATIC RESET FROM POSITION 1-2 TO THE NEUTRAL POSITION		RELAY WITH MAKE CONTACT, DELAYED WHEN RELEASING																																																																																																																						
	BREAK CONTACT WHICH IS LATE WHEN OPERATING AND EARLY WHEN RELEASING		RELAY WITH MAKE CONTACT, DELAYED WHEN OPERATING AND RELEASING		ELECTRO-MECHANICAL POSITION INDICATOR WITH ONE DE-ENERGIZED AND ONE OPERATED POSITION																																																																																																																						
	SWITCHING DEVICE WITH MANUAL CONTROL				ELECTRO-MECHANICAL POSITION INDICATOR WITH ONE DE-ENERGIZED AND TWO OPERATED POSITION																																																																																																																						
	MAKE CONTACT DELAYED WHEN OPERATING				BELL, BUZZER																																																																																																																						
	BREAK CONTACT DELAYED WHEN RELEASING				SIREN , HORN																																																																																																																						
	MAKE CONTACT DELAYED WHEN OPERATING AND RELEASING																																																																																																																										
	MAIN CONTACT OF A SWITCH DISCONNECTOR																																																																																																																										
	MAIN CONTACT OF A DISCONNECTOR																																																																																																																										

AS-BUILT BY _____ DATE _____		CONTRACT NO. 11131113/00		JOB ORDER NO. S-13656		GRAPHICAL SYMBOLS FOR DIAGRAMS		الشركة الوطنية لنقل الكهرباء		نقل الكهرباء	
DRAWN BY RIZ		CHECKED BY KVR		132KV BUSBAR PROTN.MAIN-1 BU PANEL +8BP1-2		S/S 8709 - 132/13.8KV IN AL-KHARJ CITY		INDEX		PLANT NO.	
DATE STARTED 24.01.2013		DATE COMPLETED		RIYADH		SAUDI ARABIA		DRAWING NUMBER		SHEET NO.	
PRG. DEPT. CTPD		ENG. DEPT. AUT-PSAC		-		C421		CD-322993		REV. NO.	
REV. NO.		DATE		DESCRIPTION		01		012		01	
01		13 49		FACTORY ASBUILT							
00		13 04		FOR APPROVAL							



	1	2	3	4	5	6	7	8	9	10
A										
B										
C										
D										
E										
F										

SYMBOL	DESCRIPTION	SYMBOL	DESCRIPTION	SYMBOL	DESCRIPTION
	FUSE / LINK		WATTMETER		ELEMENT WITH NEGATED INHIBITING INPUT
	FUSE WITH THE SUPPLY SIDE INDICATED		VARMETER		ELEMENT WITH INPUT WHICH DOES NOT CARRY ANY LOGIC INFORMATION
	SINGLE-PHASE TRANSFORMER WITH TWO SEPARATE WINDINGS (TWO ALTERNATIVE FORMS)		POWER FACTOR METER		ELEMENT WITH POSTPONED OUTPUT
			POSITION INDICATOR		AND-ELEMENT WITH TWO INPUTS
	SINGLE-PHASE TRANSFORMER WITH FERRO MAGNETIC CORE		SYNCHROSCOPE		OR-ELEMENT WITH TWO INPUTS
	SINGLE-PHASE VOLTAGE TRANSFORMER (MULTI-LINE AND SINGLE-LINE REPRESENTATION)		RECORDING VOLTMETER		LOGIC THRESHOLD ELEMENT WITH FOUR INPUTS AND THRESHOLD VALUE 2
			RECORDING WATTMETER		ELEMENT WITH THREE INPUTS FOR "2 AND ONLY 2"
	CURRENT TRANSFORMER (MULTI-LINE AND SINGLE-LINE REPRESENTATION)		HOUR METER		EXCLUSIVE OR-ELEMENT WITH THREE INPUTS
			WATT-HOUR METER		LOGIC IDENTITY ELEMENT WITH THREE INPUTS
	CURRENT TRANSFORMER WITH TWO CORES (MULTI-LINE AND SINGLE-LINE REPRESENTATION)		WATT-HOUR METER FOR ENERGY FROM A BUSBAR SYSTEM		MAJORITY ELEMENT WITH THREE INPUTS
			ELEMENT WITH STATIC INPUT		NEGATOR
	CURRENT TRANSFORMER WITH TWO SECONDARY WINDINGS ON ONE CORE (MULTI-LINE AND SINGLE-LINE REPRESENTATION)		ELEMENT WITH STATIC NEGATED INPUT		NAND ELEMENT WITH TWO INPUTS
			ELEMENT WITH STATIC NEGATED OUTPUT		NOR ELEMENT WITH TWO INPUTS
	FILTER		ELEMENT WITH DYNAMIC INPUT		BISTABLE ELEMENT
	HIGH-PASS FILTER		ELEMENT WITH DYNAMIC NEGATED INPUT		
	BAND-PASS FILTER		ELEMENT WITH INHIBITING INPUT		
	VOLTMETER				
	AMMETER				

AS-BUILT BY _____ DATE _____		CONTRACT NO. 11131113/00		JOB ORDER NO. S-13656		GRAPHICAL SYMBOLS FOR DIAGRAMS		الشركة الوطنية لنقل الكهرباء		نقل الكهرباء	
DRAWN BY RIZ		CHECKED BY KVR		132KV BUSBAR PROTN.MAIN-1 BU PANEL +BBP1-2		S/S 8709 - 132/13.8KV IN AL-KHARJ CITY		INDEX		PLANT NO.	
DATE STARTED 24.01.2013		DATE COMPLETED		RIYADH		SAUDI ARABIA		DRAWING NUMBER		SHEET NO.	
PRG. DEPT. CTPD		ENG. DEPT. AUT-PSAC						CD-322993		012 013	
REV. NO.		DATE		DESCRIPTION						REV. NO.	
01		13 49		FACTORY ASBUILT						01	
00		13 04		FOR APPROVAL						01	

## LEGENDS

±R1	DC SUPPLY - MAIN PROTECTION
±R2	DC SUPPLY - SECONDARY PROTECTION
±R3	DC SUPPLY - BACK UP PROTECTION
±IT	DC SUPPLY - INTER TRIP
FL	DC SUPPLY - FLASHING CIRCUIT
BB RS±	DC SUPPLY - BUS BAR - PROTECTION RESET
BB CBF±/CBF±	DC SUPPLY - CBF PROTECTION
R	RESET BUS - ALARM SYSTEM
CR	CONTROL ROOM
ECC	ENERGY CONTROL CENTRE
LOCAL	THE LOCATION OF CONTROLLED DEVICE
REMOTE	ANY OTHER LOCATION NOT LOCAL
ON	CB NORMALLY OPEN AUXILIARY CONTACT
OFF	CB NORMALLY CLOSED AUXILIARY CONTACT
A	COMMON
T	TEST POSITION
S	SERVICE POSITION
CS	CLOSE IN SERVICE POSITION
CT	CLOSE IN TEST POSITION
LS	LOCAL SERVICE
LT	LOCAL TEST
LC	LOCAL CLOSE
LO	LOCAL OPEN
RO	REMOTE OPEN
OP	OPERATE
RE	RESET

## NOTES

### LABELS

WHITE LABEL WITH BLACK LETTERING WILL BE PROVIDED FOR ALL MOUNTED APPARATUS EQUIPMENT IDENTIFICATION AND FUNCTION REFERENCE LABEL WILL BE PROVIDED FOR FRONT MOUNTED EQUIPMENTS OF THE PANEL AND EQUIPMENT IDENTIFICATION LABEL WILL BE PROVIDED FOR INTERNALLY MOUNTED EQUIPMENTS

### WIRING

PVC INSULATED 600V GRADE  
 2.5 SQ.mm. YELLOW COLOURED FOR CT CIRCUITS  
 2.5 SQ.mm. RE COLOURED FOR VT CIRCUITS  
 1.5 SQ.mm. GREY COLOURED FOR DC SUPPLY, SCADA AND CONTROL CIRCUITS  
 2.5 SQ.mm. BLACK COLOURED FOR AVC AND AC CIRCUITS  
 2.5 SQ.mm. YELLOW/GREEN COLOURED FOR EARTHING CONNECTIONS  
 FOLLOWING MARKERS SHALL BE PROVIDED ON FOLLOWING WIRES:  
 + SIGN FOR DC + WIRE  
 - SIGN FOR DC - WIRE

### LUGS

A. CT CIRCUITS- RING TYPE  
 B. OTHER CIRCUITS - SPADE TYPE


### FERULLING

YELLOW TUBE 3.2 mm FOR 1.5SQ mm WIRES AND 4.2 FOR 2.5 SQ mm WIRES  
 ( AS PER 31 - TMSS-1, RE.0 )

AS-BUILT BY _____ DATE _____		CONTRACT NO. <b>11131113/00</b>		JOB ORDER NO. <b>S-13656</b>		<b>COMMON LEGEND</b>		الشركة الوطنية لنقل الكهرباء		نقل الكهرباء	
DRAWN BY <b>RIZ</b> CHECKED BY <b>KVR</b>		DATE STARTED <b>24.01.2013</b> DATE COMPLETED _____		132KV BUSBAR PROT.N.MAIN-1 BU PANEL +BBP1-2		S/S 8709 - 132/13.8KV IN AL-KHARJ CITY		INDEX		PLANT NO.	
PRG. DEPT. <b>CTPD</b> ENG. DEPT. <b>AUT-PSAC</b>		RIYADH		SAUDI ARABIA		DRAWING NUMBER		SHEET NO.		REV. NO.	
REV. NO.		DATE		DESCRIPTION		- <b>C421</b>		<b>CD-322993</b>		<b>013 014 01</b>	
<b>01</b>		<b>13 49</b>		<b>FACTORY ASBUILT</b>							
<b>00</b>		<b>13 04</b>		<b>FOR APPROVAL</b>							


- NOTE:1 ADDITIONAL MARKING AS APPLICABLE
- NOTE:2 FERRULE NUMBERING WILL BE BLACK LETTERS ON YELLOW TUBE  
3.2 mm for 1.5 sq mm wires and  
4.2 mm for 2.5 sq mm wires  
( As per 31-TWSS-1, REV 0 )
- NOTE:3 STARTING POINT OF THE FERRULE LEFT TO RIGHT

# FOR 132kV RELAY & CONTROL, PROT.N. PANELS

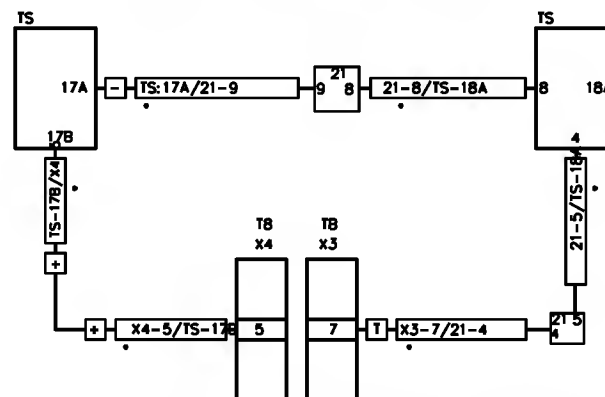

AS PER IEC-391 FIG 14a (W/O SUPPLEMENTARY/IDENTIFICATION MARK)

## FOR 132kV PANELS INTERPANEL WIRING

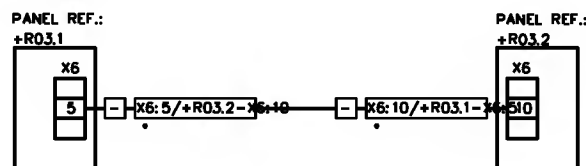

AS PER IEC-391 FIG 14d (W/O SUPPLEMENTARY/IDENTIFICATION MARK)

WIRES -  
PVC insulated, stranded,  
coiled annealed copper  
conductor graded for 1000V

- a. CT Circuits - 2.5 Sqmm PVC Yellow colour
- b. VT Circuits - 1.5 Sqmm PVC Red colour
- c. DC, & CONTROL Circuits - 1.5 Sqmm PVC Grey colour
- d. Alarm Circuits - 1.0 Sqmm PVC Blue colour
- e. AVC & AC Circuits - 2.5 Sqmm PVC Black colour
- f. Earth Circuits - 2.5 Sqmm PVC Yellow/Green colour

LUGS -  
Pre-insulated

- a) CT Circuits - Ring type
- b) Other Circuits - Spode type

AS-BUILT BY \_\_\_\_\_ DATE \_\_\_\_\_ CONTRACT NO. 11131113/00 JOB ORDER NO. S-13656

01 13 49 FACTORY ASBUILT  
00 13 04 FOR APPROVAL

DRAWN BY RIZ CHECKED BY KVR  
DATE STARTED 24.01.2013 DATE COMPLETED \_\_\_\_\_  
OPRG. DEPT. CTPD ENG. DEPT. AUT-PSAC

## FERRULE AND WIRING DETAILS


132KV BUSBAR PROT.N.MAIN-1 BU PANEL +BBP1-2  
S/S 8709 - 132/13.8KV IN AL-KHARJ CITY  
RIYADH SAUDI ARABIA

الشركة الوطنية لنقل الكهرباء

نقل الكهرباء  
National Grid sa

INDEX	PLANT NO.	DRAWING NUMBER	SHEET NO.	REV. NO.
-	C421	CD-322993	014	015


	1	2	3	4	5	6	7	8	9	10
A										
B										
C										
D										
E										
F										
G										

MANUFACTURER		SCHEMATICS OWG.NO	PANEL DESCRIPTION	PANEL REFERENCE
 PROTECTION & SUBSTATION AUTOMATION			SS 8709 132kV RELAY PANELS	
		CD-322928	132/13.8kV GT-1 RELAY PANEL -1 132/13.8kV GT-1 RELAY PANEL -2	+R05.1 +R05.2
		CD-322931	132/13.8kV GT-2 RELAY PANEL -1 132/13.8kV GT-2 RELAY PANEL -2	+R01.1 +R01.2
		CD-322934	132/13.8kV GT-3 RELAY PANEL -1 132/13.8kV GT-3 RELAY PANEL -2	+R04.1 +R04.2
		CD-322936	132/13.8kV TRANSFORMER-1,2& 3 AVC PANEL	+AVC
		CD-322922	132KV SPARE-1 UGF RELAY PANEL -1 132KV SPARE-1 UGF RELAY PANEL -2	+R07.1 +R07.2
		CD-322916	132KV 8020 UGF RELAY PANEL -1 132KV 8020 UGF RELAY PANEL -2	+R02.1 +R02.2
		CD-322919	132KV 8710 UGF RELAY PANEL -1 132KV 8710 UGF RELAY PANEL -2	+R03.1 +R03.2
		CD-322925	132KV SPARE-2 UGF RELAY PANEL -1 132KV SPARE-2 UGF RELAY PANEL -2	+R06.1 +R06.2
		CD-323012	132KV FOP PANEL	+FOP
		CD-322946	132kV BUS COUPLER-A	+R130
		CD-322948	132kV BUS COUPLER-B	+R230
		CD-322950	132kV BUS SECTION	+R120
		CD-322991	132kV BUSBAR PROTECTION MAIN-1 CENTRAL UNIT PANEL	+BBP1-1
		CD-322993	132kV BUSBAR PROTECTION MAIN-1 BAY UNIT PANEL	+BBP1-2
		CD-322995	132kV BUSBAR PROTECTION MAIN-1 BAY UNIT PANEL	+BBP1-3
		CD-322997	132kV BUSBAR PROTECTION MAIN-1 BAY UNIT PANEL	+BBP1-4
		CD-322999	132kV BUSBAR PROTECTION MAIN-1 BAY UNIT PANEL	+BBP1-5
		CD-323001	132kV BUSBAR PROTECTION MAIN-2 CENTRAL UNIT PANEL	+BBP2-1
		CD-323003	132kV BUSBAR PROTECTION MAIN-2 BAY UNIT PANEL	+BBP2-2
		CD-323005	132kV BUSBAR PROTECTION MAIN-2 BAY UNIT PANEL	+BBP2-3
		CD-323007	132kV BUSBAR PROTECTION MAIN-2 BAY UNIT PANEL	+BBP2-4
		CD-323009	132kV BUSBAR PROTECTION MAIN-2 BAY UNIT PANEL	+BBP2-5

AS-BUILT BY _____ DATE _____		CONTRACT NO. 11131113/00	JOB ORDER NO. S-13656	DRAWING REFERENCES		الشركة الوطنية لنقل الكهرباء		نقل الكهرباء	
01	13 49	FACTORY ASBUILT		DRAWN BY RIZ	CHECKED BY KVR	132KV BUSBAR PROTN.MAIN-1 BU PANEL +BBP1-2		National Grid sa	
00	13 04	FOR APPROVAL		DATE STARTED 24.01.2013 DATE COMPLETED _____		S/S 8709 - 132/13.8KV IN AL-KHARJ CITY			
REV. NO.	DATE	DESCRIPTION		OPRG. DEPT. CTPO	ENG. DEPT. AUT-PSAC	INDEX	PLANT NO. C421	DRAWING NUMBER	SHEET NO.
								CD-322993	015 016
									01

SAUDI ARABIA		RIYADH	
--------------	--	--------	--

	1	2	3	4	5	6	7	8	9	10																																												
A																																																						
B																																																						
C																																																						
D																																																						
E																																																						
F																																																						
G																																																						
<table><tr><td colspan="3">AS-BUILT BY _____ DATE _____</td><td colspan="2">CONTRACT NO. 11131113/00</td><td colspan="2">JOB ORDER NO. S-13656</td><td colspan="2">DRAWING REFERENCES</td><td colspan="2">الشركة الوطنية لنقل الكهرباء National Grid sa</td></tr><tr><td colspan="3">01 13 49 FACTORY ASBUILT</td><td colspan="2">DRAWN BY RIZ CHECKED BY KVR</td><td colspan="2">132KV BUSBAR PROTN.MAIN-1 BU PANEL +8BP1-2</td><td colspan="2">INDEX PLANT NO. DRAWING NUMBER</td><td colspan="2">SHEET NO. REV. NO.</td></tr><tr><td colspan="3">00 13 04 FOR APPROVAL</td><td colspan="2">DATE STARTED 24.01.2013 DATE COMPLETED</td><td colspan="2">S/S 8709 - 132/13.8KV IN AL-KHARJ CITY</td><td colspan="2">- C421 CD-322993</td><td colspan="2">016 051 01</td></tr><tr><td colspan="3">REV. NO. DATE DESCRIPTION</td><td colspan="2">OPRG. DEPT. CTPD ENG. DEPT. AUT-PSAC</td><td colspan="2">RIYADH SAUDI ARABIA</td><td colspan="2"></td><td colspan="2">NG/D2-D (2012/01) DMS VECTOR NGD200</td></tr></table>											AS-BUILT BY _____ DATE _____			CONTRACT NO. 11131113/00		JOB ORDER NO. S-13656		DRAWING REFERENCES		الشركة الوطنية لنقل الكهرباء National Grid sa		01 13 49 FACTORY ASBUILT			DRAWN BY RIZ CHECKED BY KVR		132KV BUSBAR PROTN.MAIN-1 BU PANEL +8BP1-2		INDEX PLANT NO. DRAWING NUMBER		SHEET NO. REV. NO.		00 13 04 FOR APPROVAL			DATE STARTED 24.01.2013 DATE COMPLETED		S/S 8709 - 132/13.8KV IN AL-KHARJ CITY		- C421 CD-322993		016 051 01		REV. NO. DATE DESCRIPTION			OPRG. DEPT. CTPD ENG. DEPT. AUT-PSAC		RIYADH SAUDI ARABIA				NG/D2-D (2012/01) DMS VECTOR NGD200	
AS-BUILT BY _____ DATE _____			CONTRACT NO. 11131113/00		JOB ORDER NO. S-13656		DRAWING REFERENCES		الشركة الوطنية لنقل الكهرباء National Grid sa																																													
01 13 49 FACTORY ASBUILT			DRAWN BY RIZ CHECKED BY KVR		132KV BUSBAR PROTN.MAIN-1 BU PANEL +8BP1-2		INDEX PLANT NO. DRAWING NUMBER		SHEET NO. REV. NO.																																													
00 13 04 FOR APPROVAL			DATE STARTED 24.01.2013 DATE COMPLETED		S/S 8709 - 132/13.8KV IN AL-KHARJ CITY		- C421 CD-322993		016 051 01																																													
REV. NO. DATE DESCRIPTION			OPRG. DEPT. CTPD ENG. DEPT. AUT-PSAC		RIYADH SAUDI ARABIA				NG/D2-D (2012/01) DMS VECTOR NGD200																																													

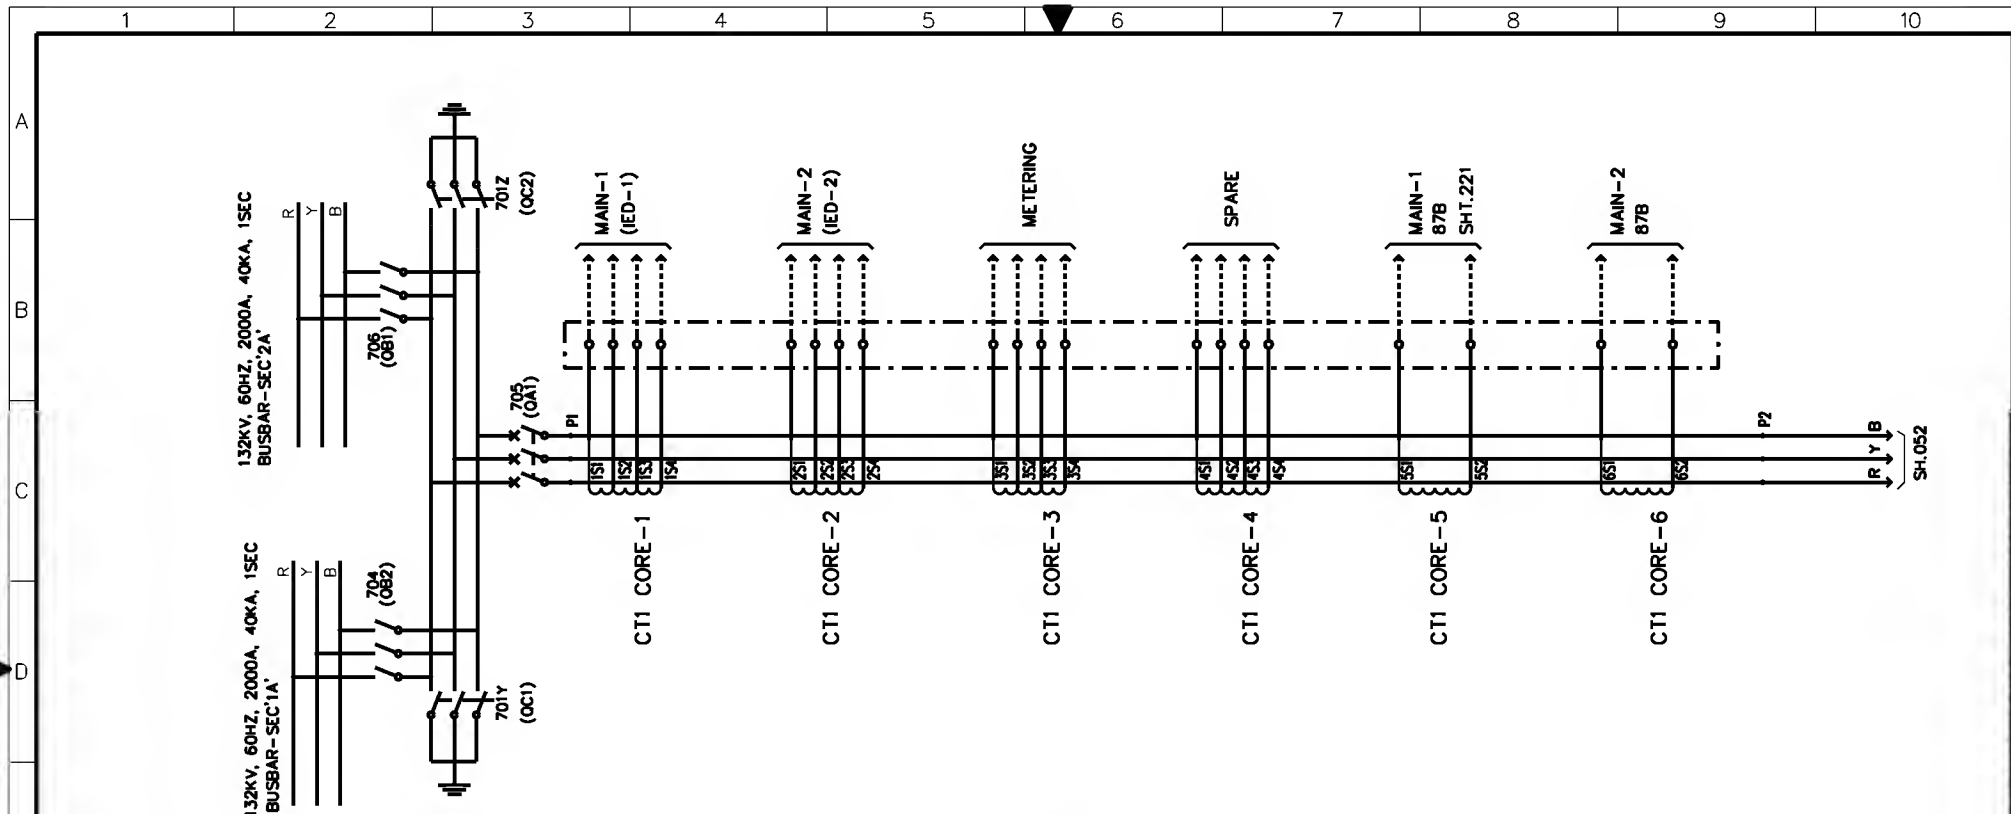

CT	RATIO	CLASS	VK IN VOLTS	IMAG @ VK IN mA	RCT IN (OHMS)	BURDEN IN VA	FUNCTION
CT1-1	1600-1200-800/1A	X	>1400	≤100	≤2	-	MAIN-1(IED-1)
CT1-2	1600-1200-800/1A	X	>1400	≤100	≤2	-	MAIN-2(IED-2)
CT1-3	1600-1200-800/1A	X	>1400	≤100	≤2	-	METERING
CT1-4	1600-1200-800/1A	X	>1400	≤100	≤2	-	SPARE
CT1-5	2000/1A	X	>600	≤25	≤5	-	87B MAIN-1
CT1-6	2000/1A	X	>600	≤25	≤5	-	87B MAIN-2

AS-BUILT BY \_\_\_\_\_ DATE \_\_\_\_\_ CONTRACT NO. **11131113/00** JOB ORDER NO. **S-13656**

01	13 49	FACTORY ASBUILT	DRAWN BY <b>RIZ</b> CHECKED BY <b>KVR</b>
00	13 04	FOR APPROVAL	DATE STARTED <b>24.01.2013</b> DATE COMPLETED _____
REV. NO.	DATE	DESCRIPTION	OPRG. DEPT. <b>CTPD</b> ENG. DEPT. <b>AUT-PSAC</b>

**PRIMARY SYSTEM (SPARE-1 UCF BAY-D07)**  
**132KV BUSBAR PROTN.MAIN-1 BU PANEL +BBP1-2**  
**S/S 8709 - 132/13.8KV IN AL-KHARJ CITY**  
**RIYADH SAUDI ARABIA**


الشركة الوطنية لنقل الكهرباء		نقل الكهرباء	
National Grid sa		National Grid sa	
INDEX	PLANT NO.	DRAWING NUMBER	SHEET NO.
-	C421	CD-322993	051 052
			REV. NO. 01










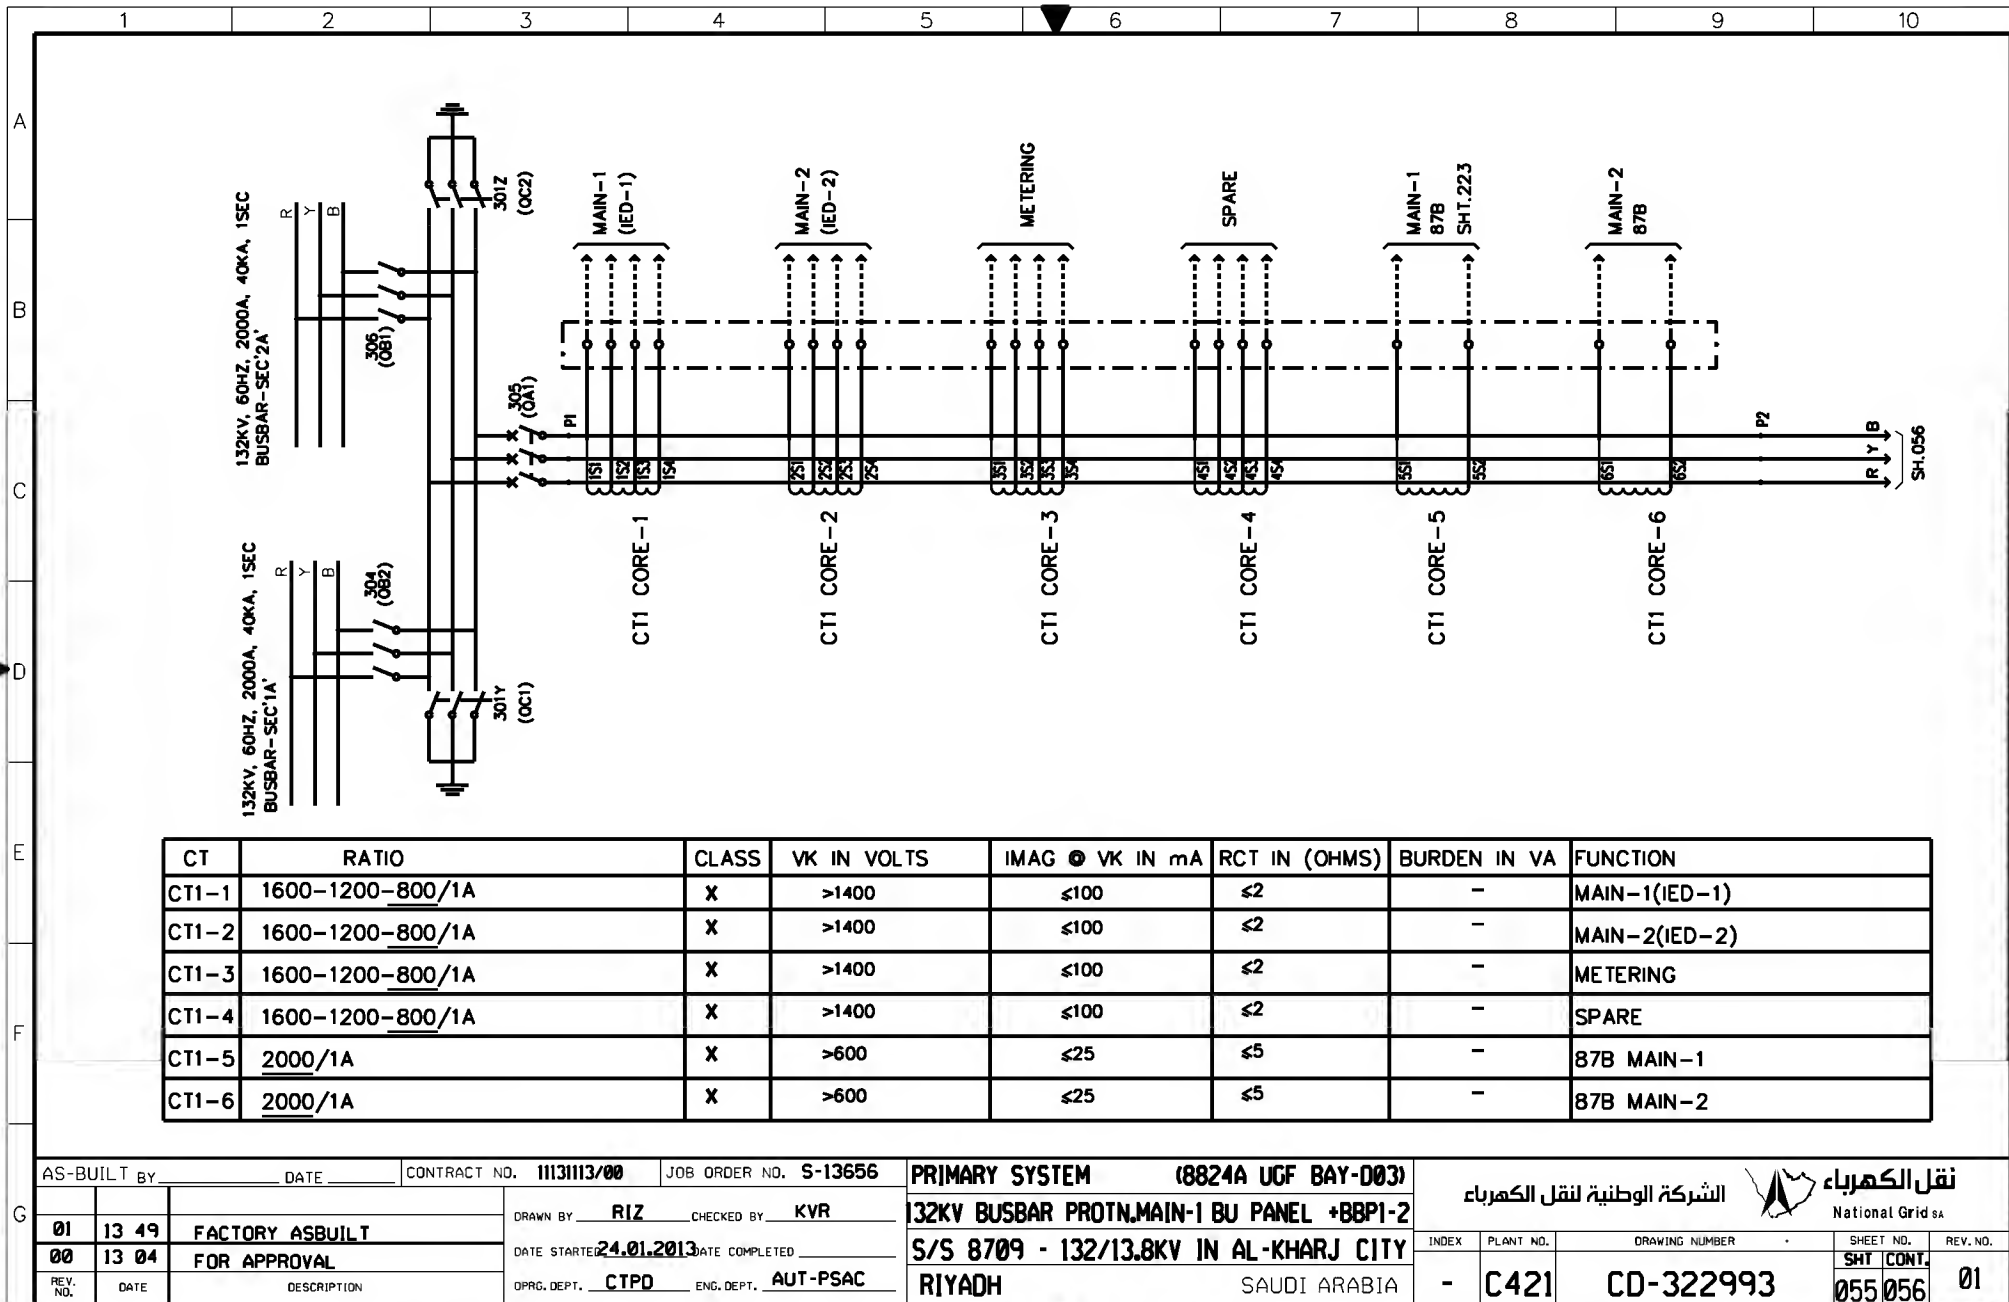

THIS DRAWING AND THE INFORMATION CONTAINED HEREIN ARE THE SOLE PROPERTY OF NATIONAL GRID SA. NO REPRODUCTION OR TRANSMISSION IN ANY FORM OR BY ANY MEANS, WITHOUT THE WRITTEN CONSENT OF NATIONAL GRID SA, IS PERMITTED.








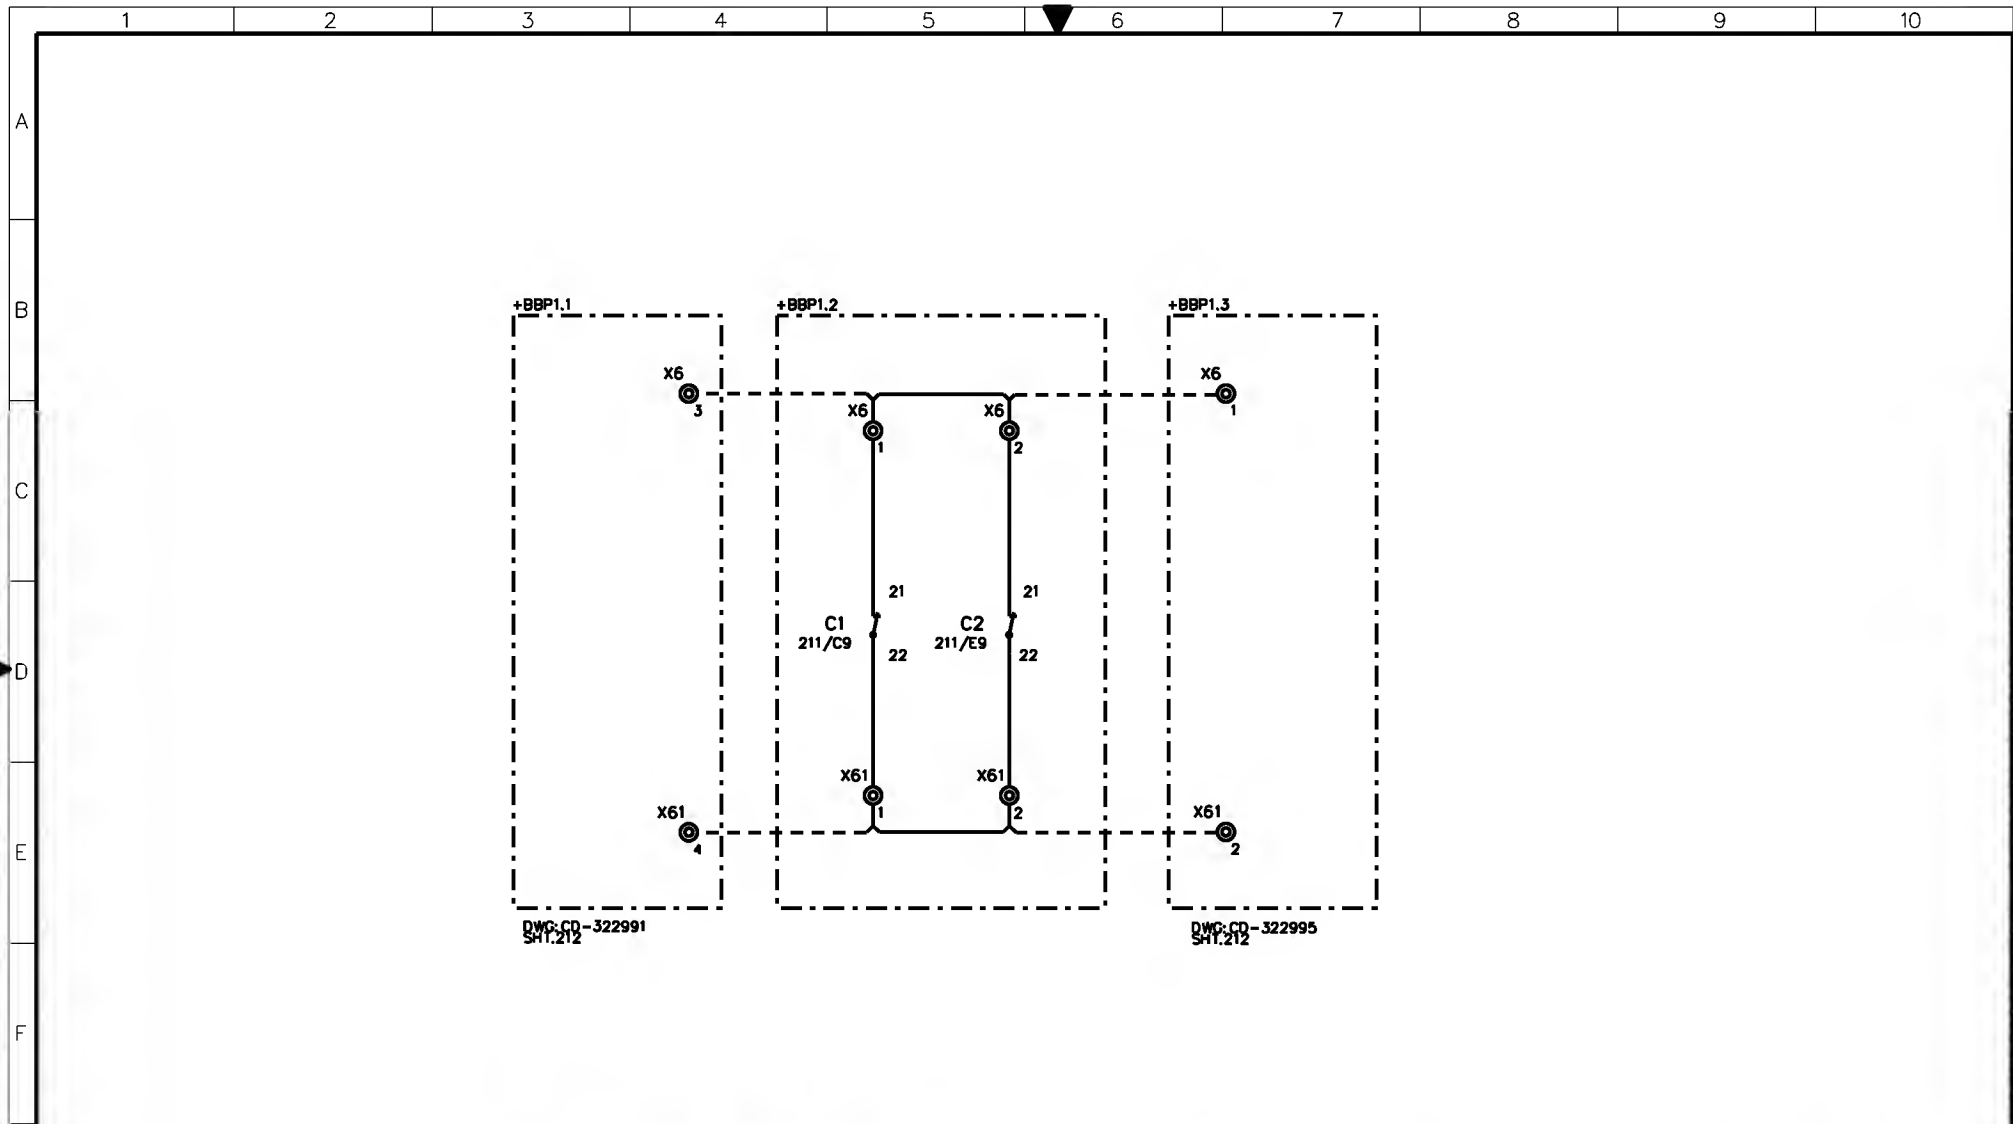


AS-BUILT BY \_\_\_\_\_ DATE \_\_\_\_\_ CONTRACT NO. **11131113/00** JOB ORDER NO. **S-13656**

01	13 49	FACTORY ASBUILT	DRAWN BY <b>RIZ</b> CHECKED BY <b>KVR</b>
00	13 04	FOR APPROVAL	DATE STARTED <b>24.01.2013</b> DATE COMPLETED _____
REV. NO.	DATE	DESCRIPTION	OPRG. DEPT. <b>CTPD</b> ENG. DEPT. <b>AUT-PSAC</b>

**CUB.LIGHTING,HEATER&SOKET ALARM CKT.**  
**132KV BUSBAR PROTN.MAIN-1 BU PANEL +BBP1-2**  
**S/S 8709 - 132/13.8KV IN AL-KHARJ CITY**  
**RIYADH SAUDI ARABIA**

الشركة الوطنية لنقل الكهرباء		نقل الكهرباء	
National Grid sa		National Grid sa	
INDEX	PLANT NO.	DRAWING NUMBER	SHEET NO.
-	C421	CD-322993	212 216
			REV. NO.
			01

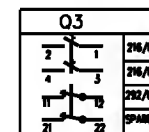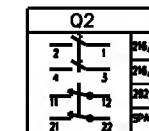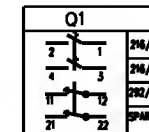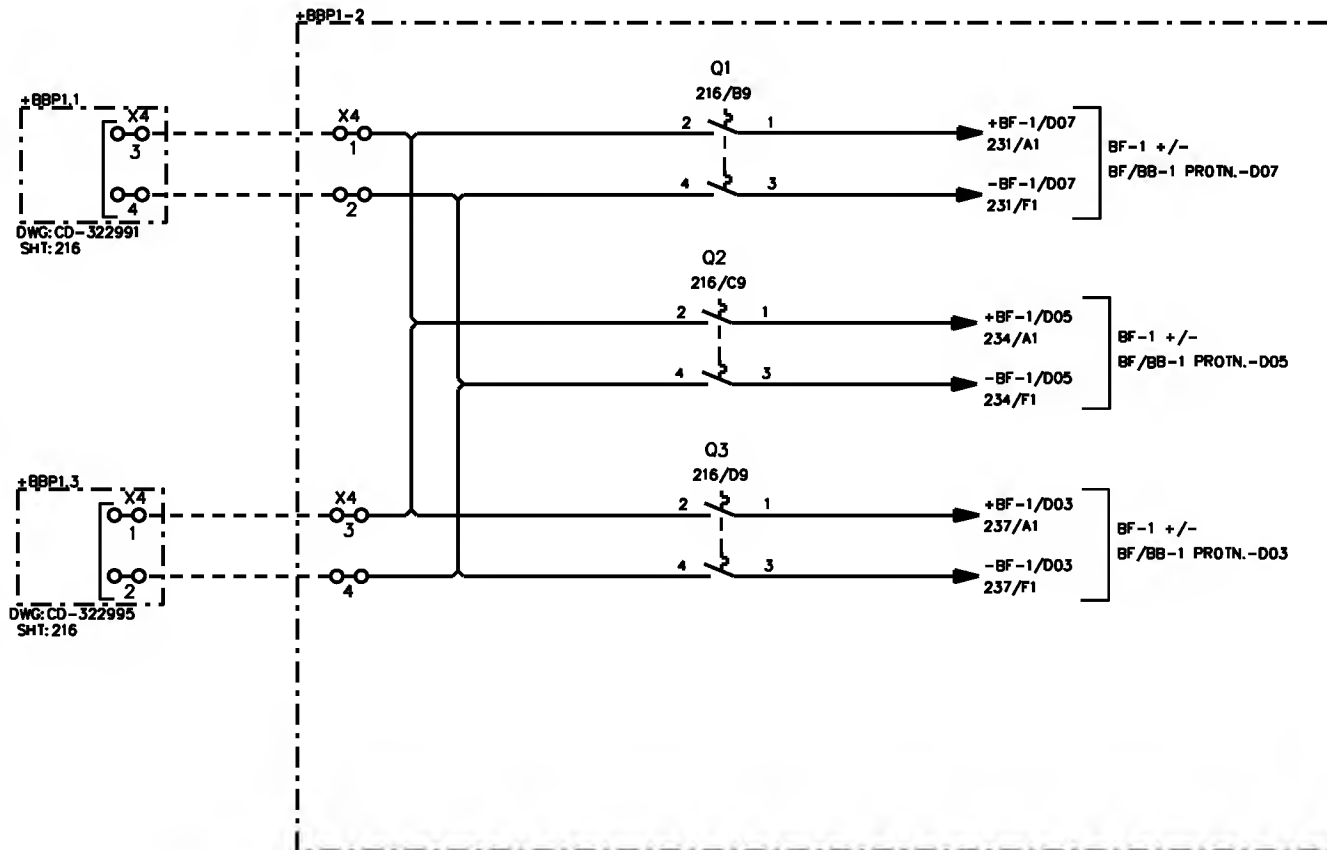


AS-BUILT BY _____ DATE _____			CONTRACT NO. <b>11131113/00</b>		JOB ORDER NO. <b>S-13656</b>		<b>DC SUPPLY DISTRIBUTION</b>			الشركة الوطنية لنقل الكهرباء			نقل الكهرباء		National Grid sa	
<b>01</b>	<b>13 49</b>	<b>FACTORY ASBUILT</b>	DRAWN BY <b>RIZ</b> CHECKED BY <b>KVR</b>		<b>132KV BUSBAR PROTN.MAIN-1 BU PANEL +BBP1-2</b>		<b>S/S 8709 - 132/13.8KV IN AL-KHARJ CITY</b>			INDEX	PLANT NO.	DRAWING NUMBER	SHEET NO.	REV. NO.		
<b>00</b>	<b>13 04</b>	<b>FOR APPROVAL</b>	DATE STARTED <b>24.01.2013</b> DATE COMPLETED _____		<b>RIYADH</b>		<b>SAUDI ARABIA</b>			-	<b>C421</b>	<b>CD-322993</b>	<b>216</b>	<b>221</b>	<b>01</b>	
REV. NO.	DATE	DESCRIPTION	OPRG. DEPT. <b>CTPD</b> ENG. DEPT. <b>AUT-PSAC</b>													












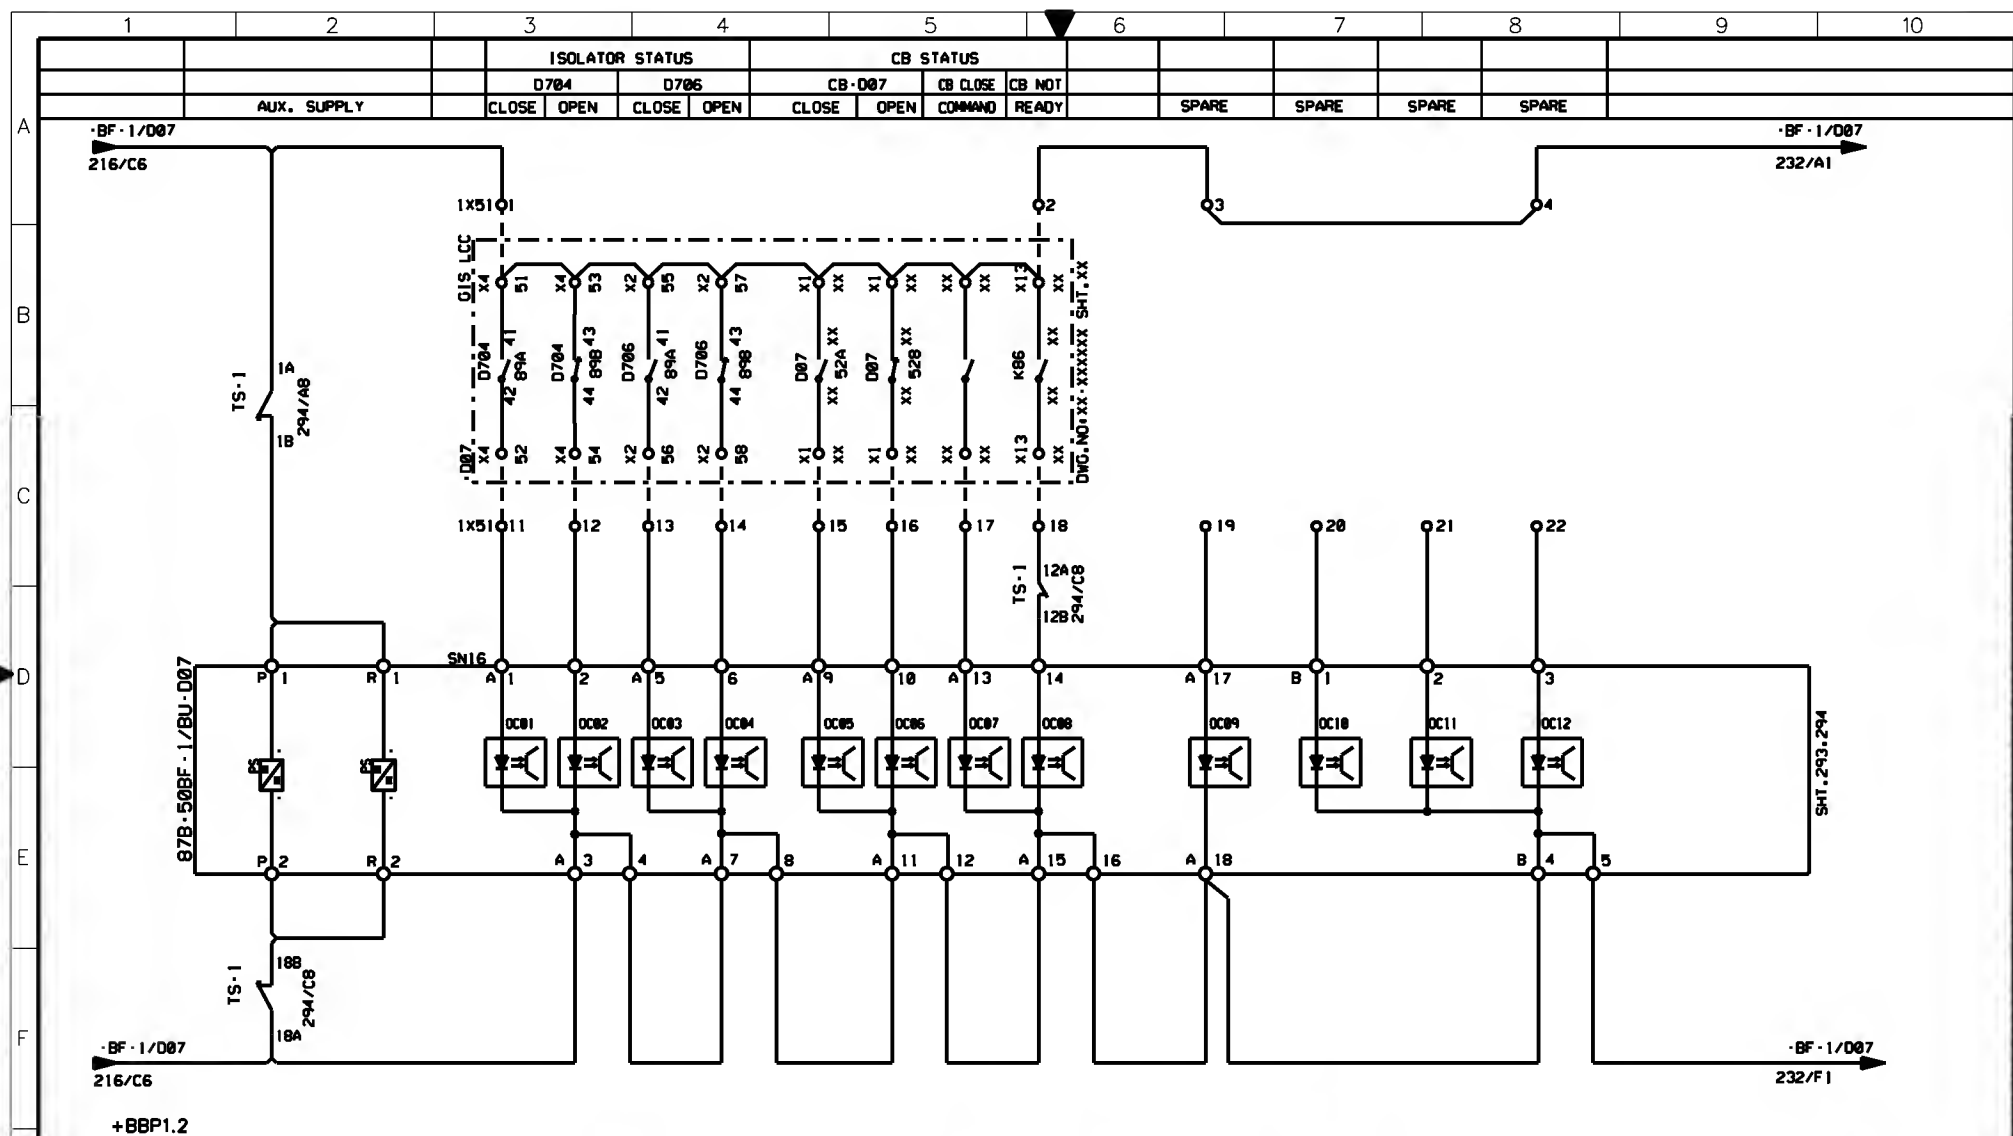

AS-BUILT BY _____ DATE _____		CONTRACT NO. 1113113/00	JOB ORDER NO. S-13656	87B-50BF-1/BU-D07 PROTECTION RELAY - BINARY INPUTS		الشركة الوطنية لنقل الكهرباء	
01	13 49	FACTORY ASBUILT		132KV BUSBAR PROTN.MAIN-1 BU PANEL +BBP1-2		National Grid sa	
00	13 04	FOR APPROVAL		S/S 8709 - 132/13.8KV IN AL-KHARJ CITY		INDEX PLANT NO. DRAWING NUMBER SHEET NO. REV. NO.	
REV. NO.	DATE	DESCRIPTION		DRAWN BY RIZ CHECKED BY KVR		- C421 CD-322993 231 232 01	
		DATE STARTED 24.01.2013 DATE COMPLETED _____		OPRG. DEPT. CTPO ENG. DEPT. AUT-PSAC			
				RIYADH SAUDI ARABIA			

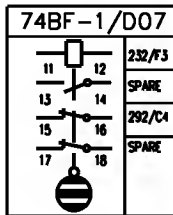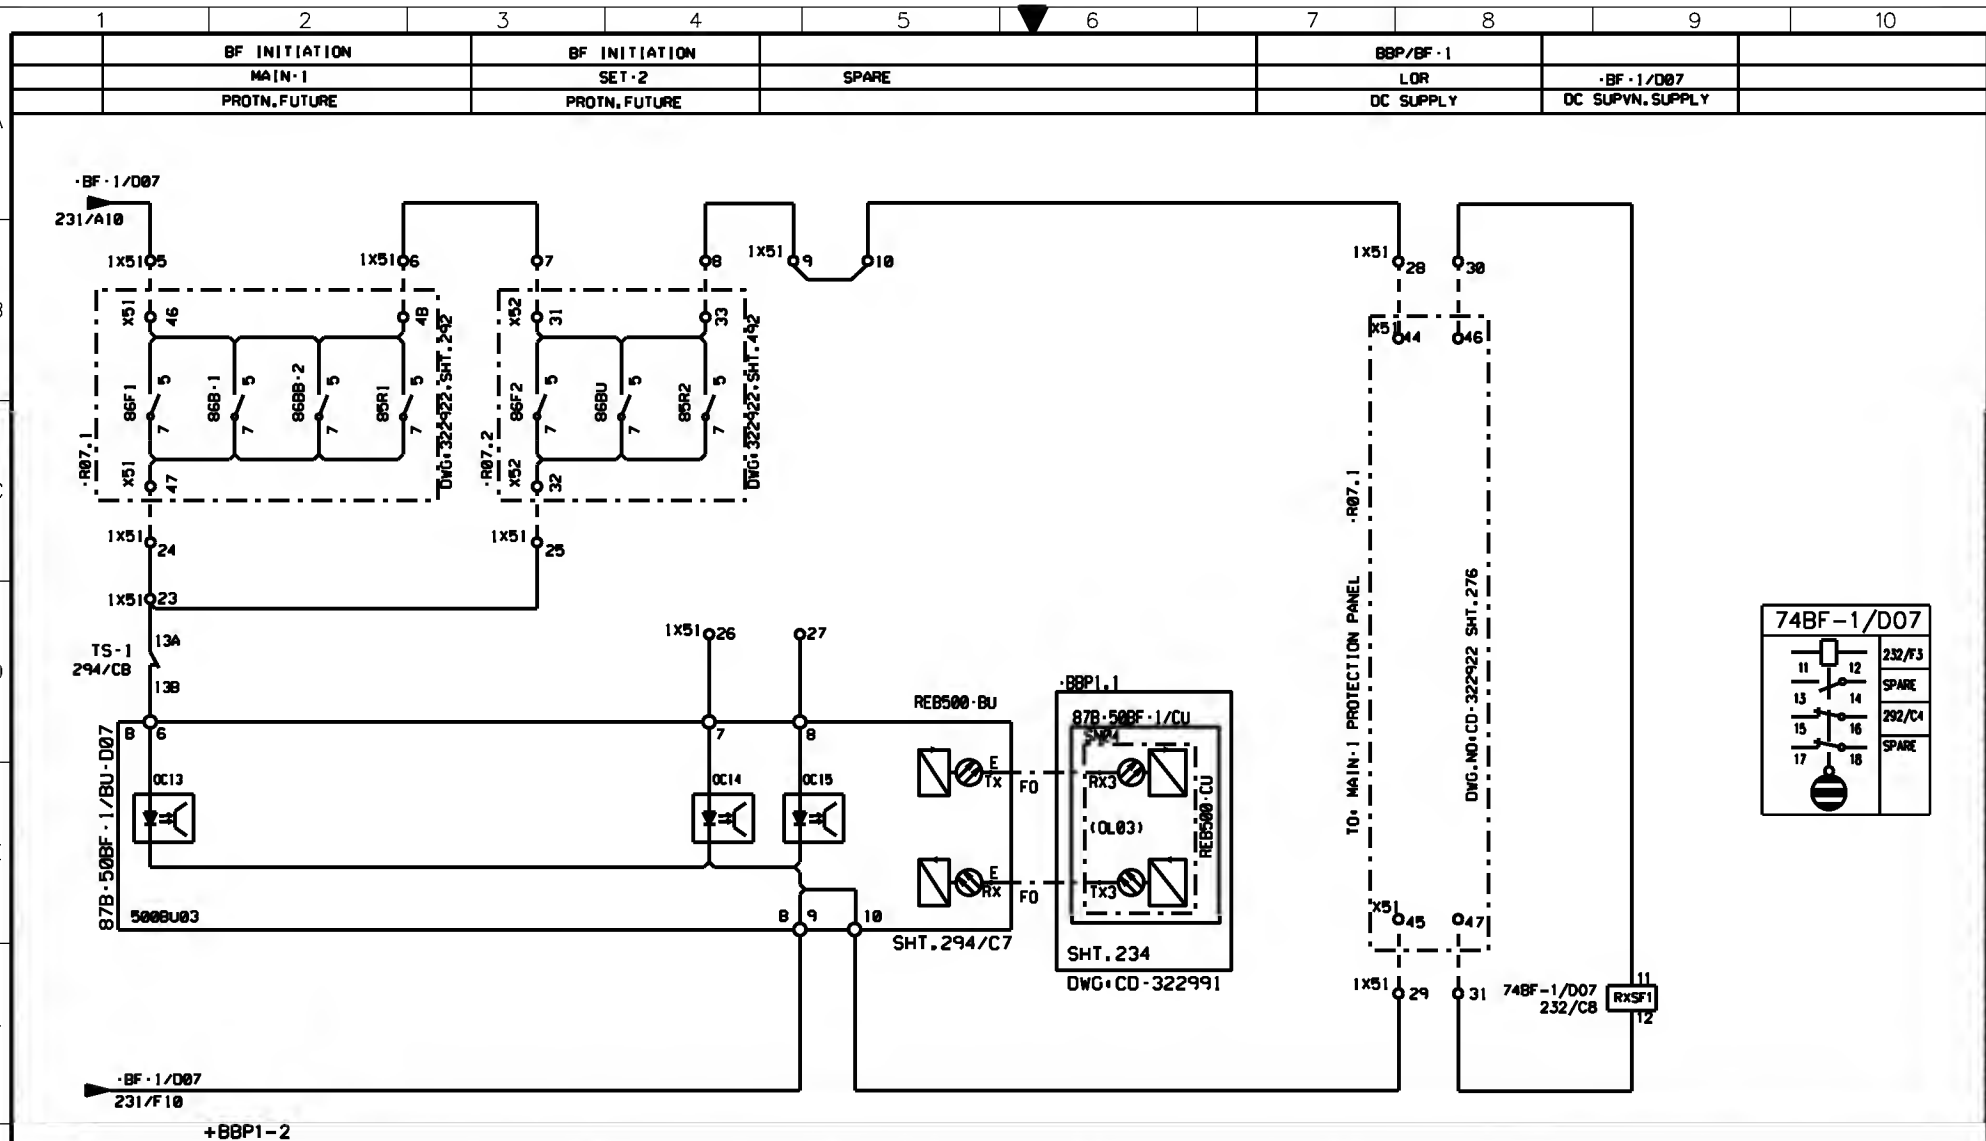



AS-BUILT BY _____ DATE _____		CONTRACT NO. 1113113/00	JOB ORDER NO. S-13656	87B-50BF-1/BU-D07 PROTECTION RELAY - BINARY INPUTS		الشركة الوطنية لنقل الكهرباء		نقل الكهرباء	
DRAWN BY RIZ CHECKED BY KVR		DATE STARTED 24.01.2013 DATE COMPLETED _____		132KV BUSBAR PROTN.MAIN-1 BU PANEL +BBP1-2		National Grid sa			
FOR APPROVAL		OPRG. DEPT. CTPD ENG. DEPT. AUT-PSAC		S/S 8709 - 132/13.8KV IN AL-KHARJ CITY		INDEX	PLANT NO.	DRAWING NUMBER	SHEET NO.
REV. NO.	DATE	DESCRIPTION		RIYADH SAUDI ARABIA		-	C421	CD-322993	232 233
01	3 49	FACTORY ASBUILT							01
00	13 04								

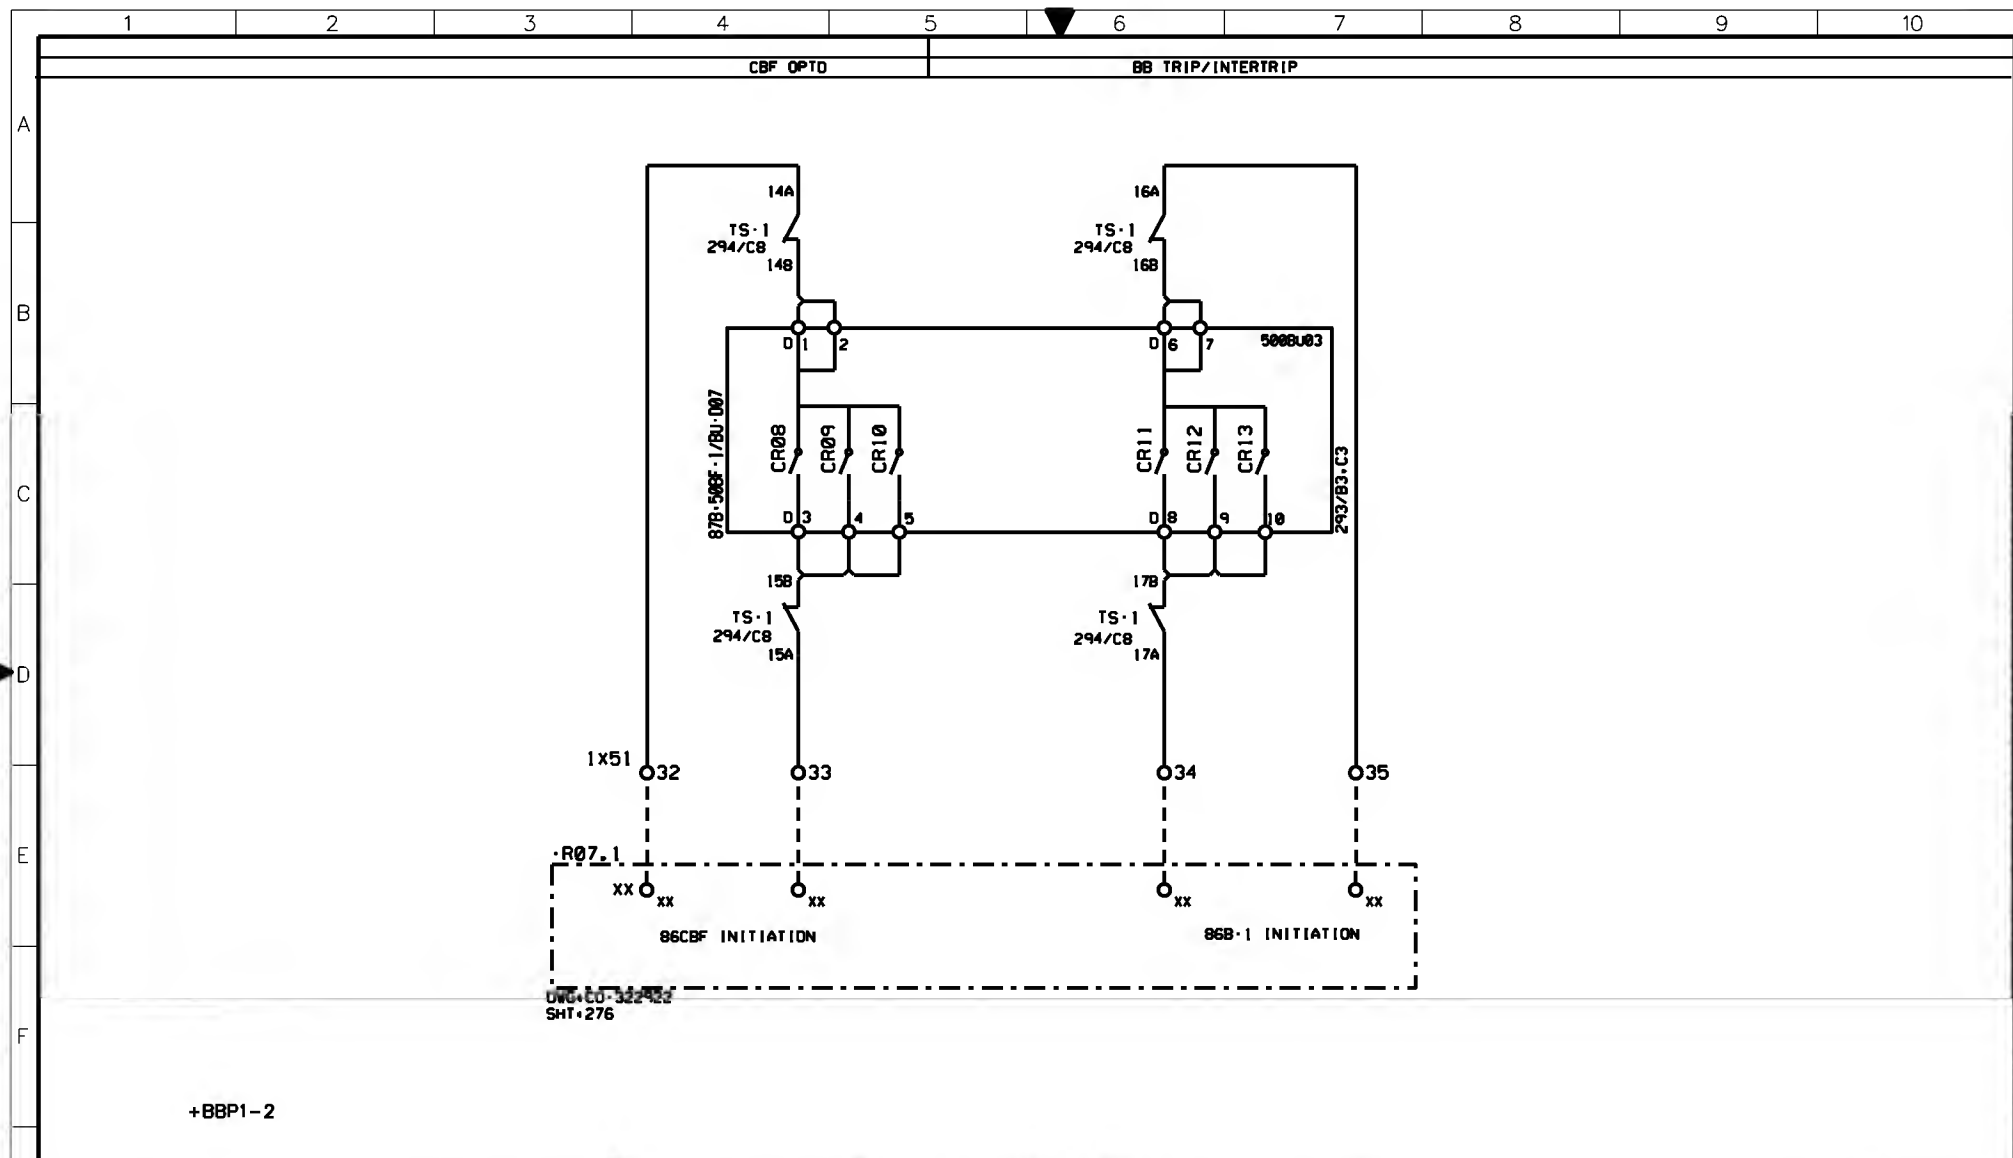

AS-BUILT BY _____ DATE _____			CONTRACT NO. 1113113/00		JOB ORDER NO. S-13656		CBF & BUSBAR PROTN-1 TRIP RELAY CIRCUIT			الشركة الوطنية لنقل الكهرباء		
01 13 49			DRAWN BY RIZ		CHECKED BY KVR		132KV BUSBAR PROTN.MAIN-1 BU PANEL +BBP1-2			National Grid sa		
00 13 04			DATE STARTED 24.01.2013		DATE COMPLETED _____		S/S 8709 - 132/13.8KV IN AL-KHARJ CITY			INDEX PLANT NO. DRAWING NUMBER SHEET NO. REV. NO.		
FOR APPROVAL			OPRG. DEPT. CTPD		ENG. DEPT. AUT-PSAC		RIYADH SAUDI ARABIA			- C421 CD-322993 233 234 01		




1	2	3	4	5	6	7	8	9	10
BF INITIATION		BF INITIATION		SPARE		BBP/BF-1		-BF-1/D05	
MAIN-1		SET-2				LOR		DC SUPVN.SUPPLY	
PROTN.FUTURE		PROTN.FUTURE				DC SUPPLY			

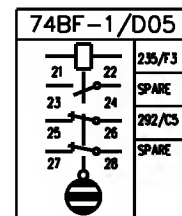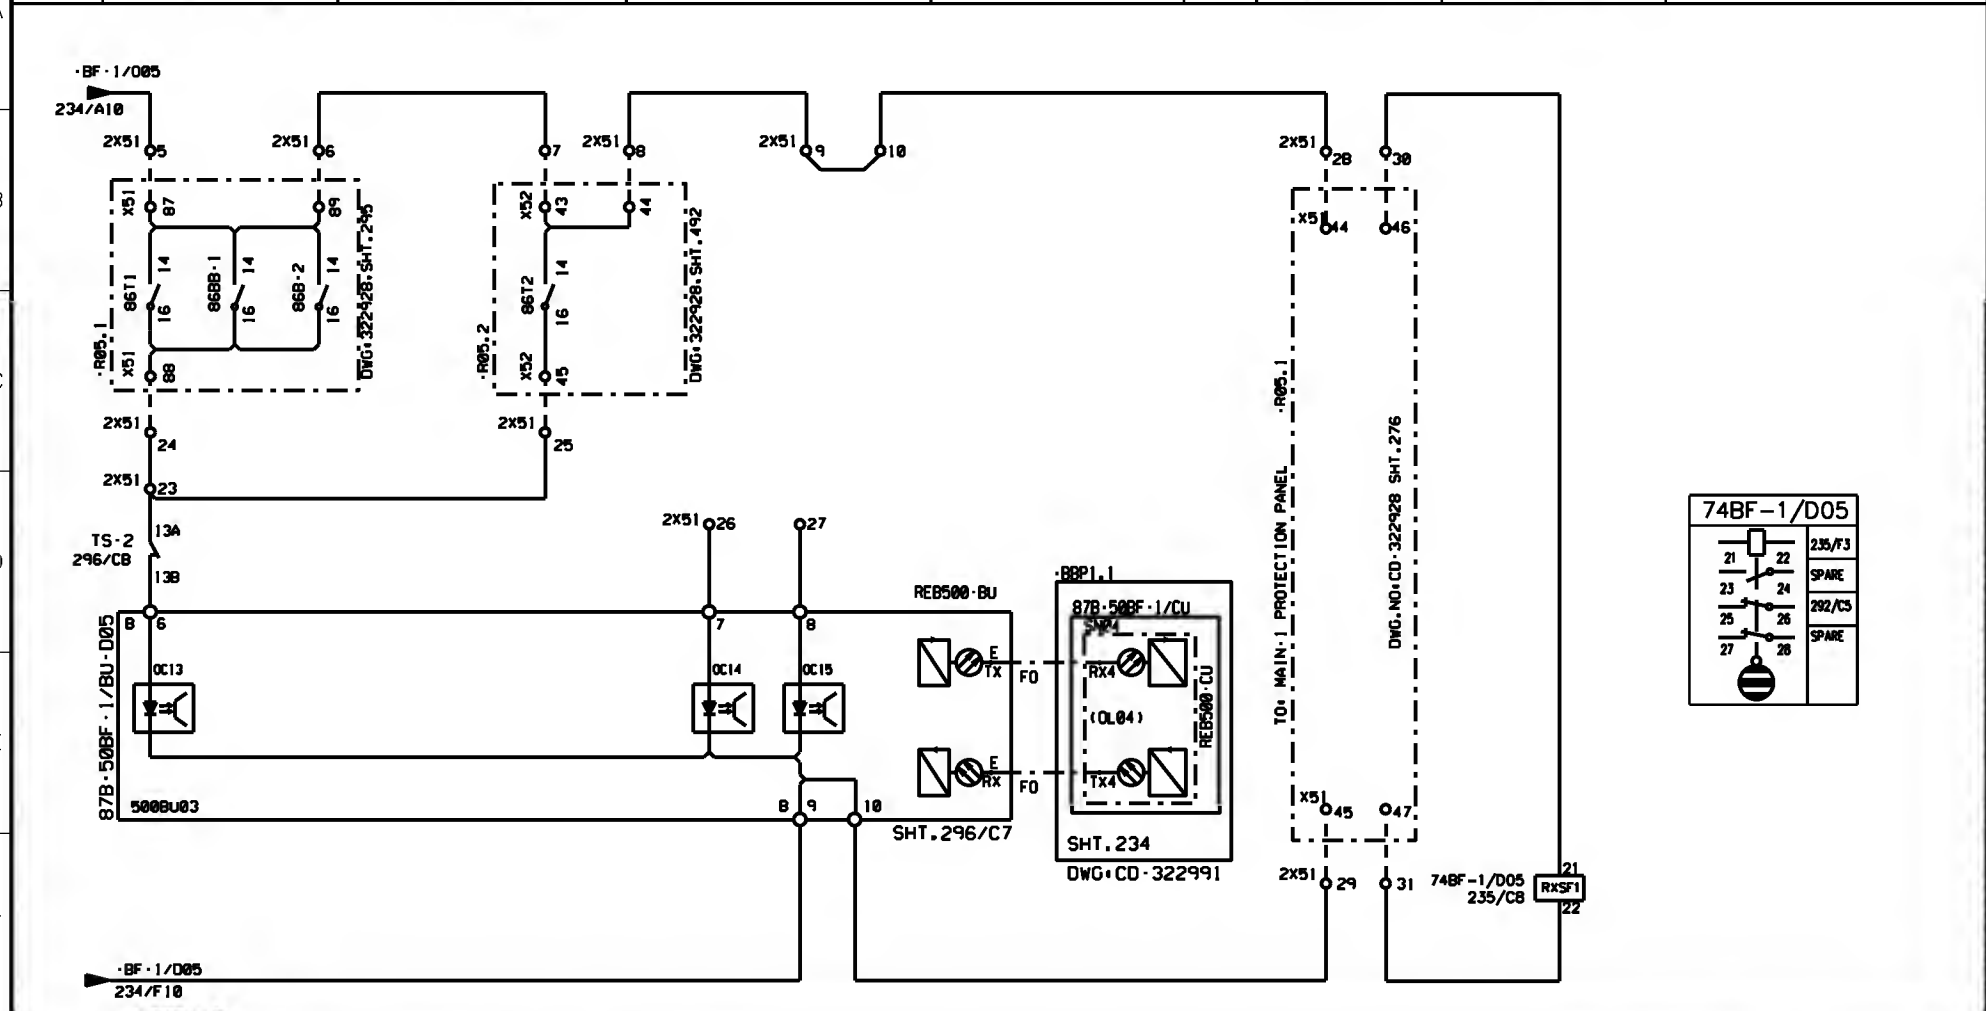

AS-BUILT BY _____ DATE _____		CONTRACT NO. 1113113/00		JOB ORDER NO. S-13656		87B-50BF-1/BU-D05 PROTECTION RELAY - BINARY INPUTS				الشركة الوطنية لنقل الكهرباء			
DRAWN BY RIZ		CHECKED BY KVR		DATE STARTED 24.01.2013		DATE COMPLETED _____		S/S 8709 - 132/13.8KV IN AL-KHARJ CITY		National Grid sa		نقل الكهرباء	
FOR APPROVAL		PRG. DEPT. CTPD		ENG. DEPT. AUT-PSAC		RIYADH		SAUDI ARABIA		INDEX PLANT NO. - C421		DRAWING NUMBER CD-322993	
REV. NO. 01		DATE 13 49		DESCRIPTION FACTORY ASBUILT		SHEET NO. 235		CONT. 236		REV. NO. 01		SHEET NO. 235	




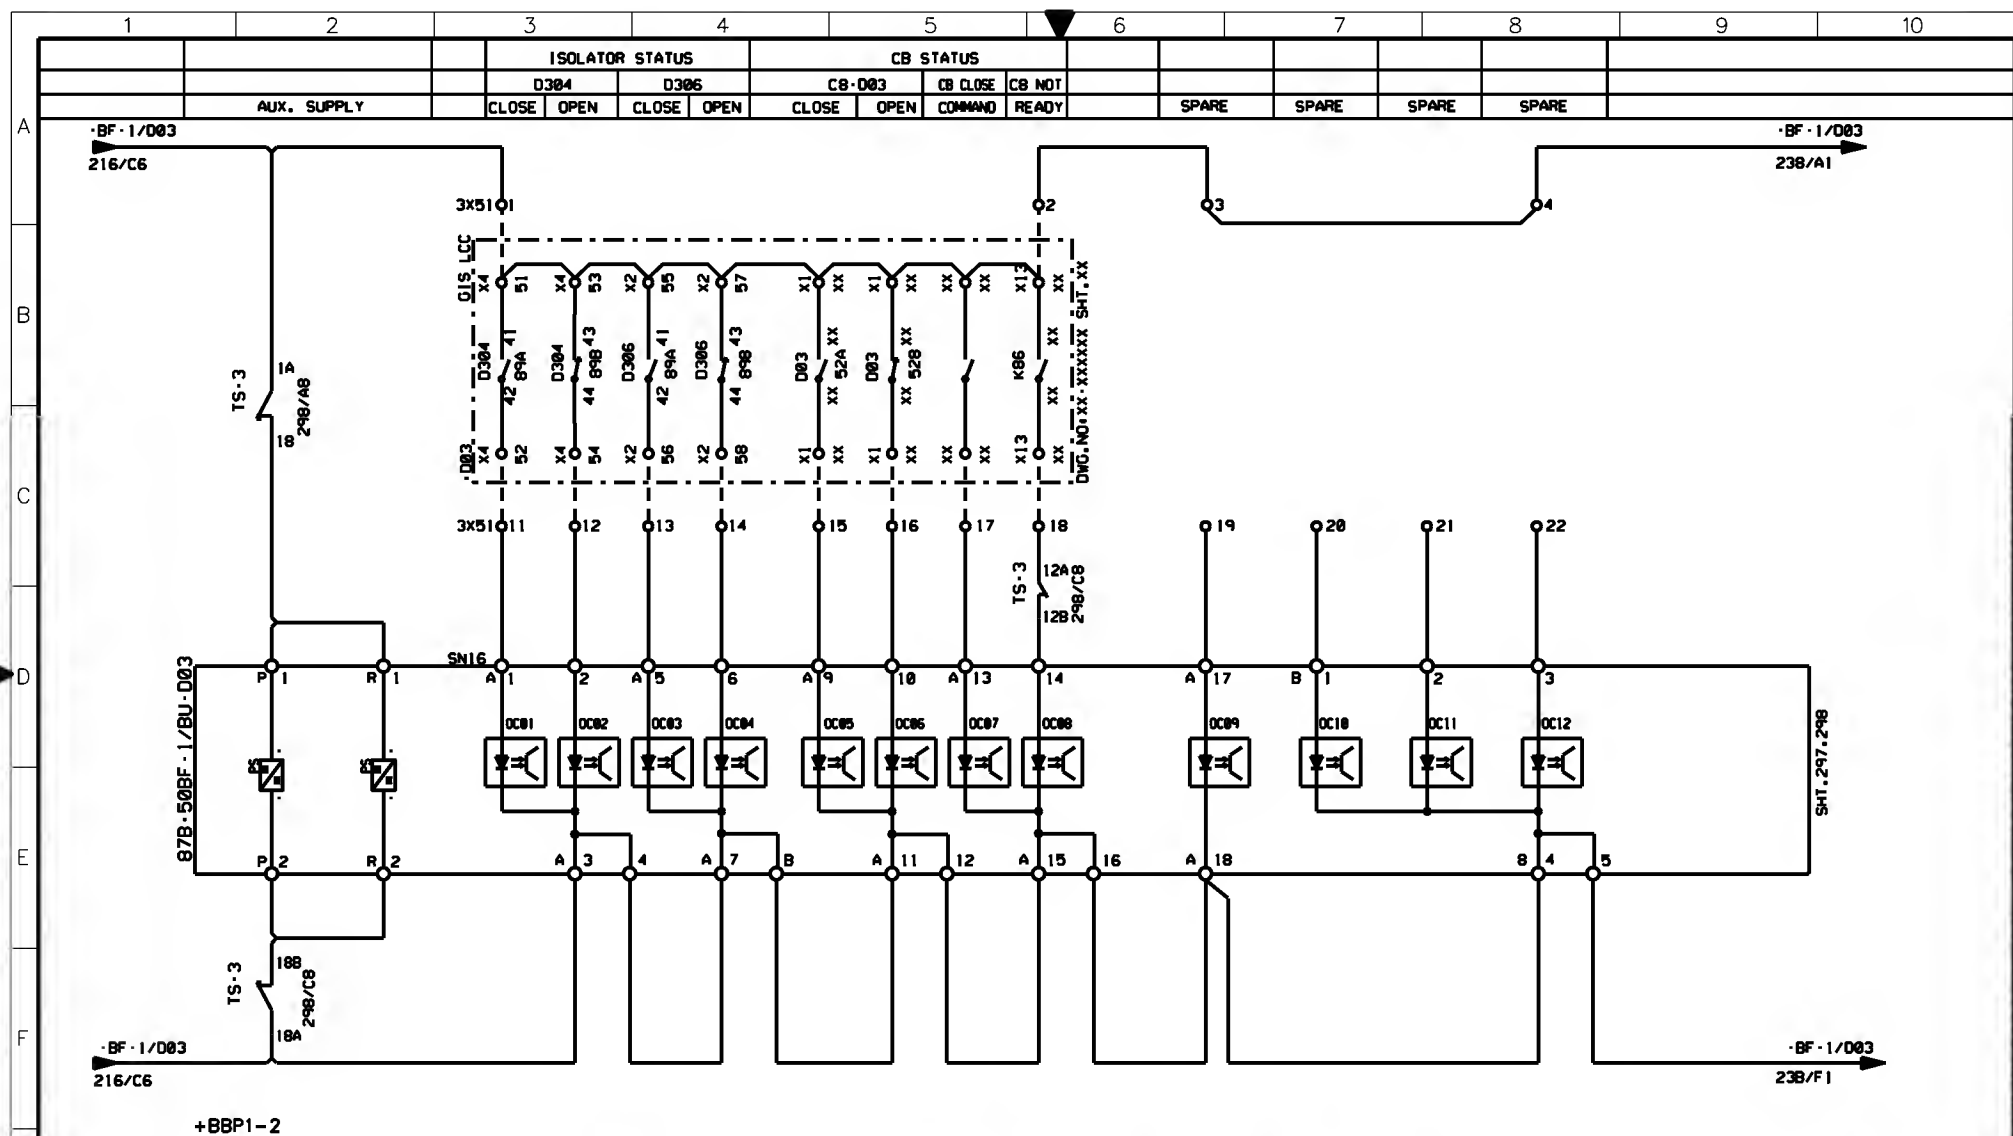

AS-BUILT BY _____ DATE _____		CONTRACT NO. 1113113/00	JOB ORDER NO. S-13656	87B-50BF-1/BU-D03 PROTECTION RELAY - BINARY INPUTS		الشركة الوطنية لنقل الكهرباء	
01	13 49	FACTORY ASBUILT		132KV BUSBAR PROTN.MAIN-1 BU PANEL +BBP1-2		National Grid sa	
00	13 04	FOR APPROVAL		S/S 8709 - 132/13.8KV IN AL-KHARJ CITY		INDEX PLANT NO. DRAWING NUMBER SHEET NO. REV. NO.	
REV. NO.	DATE	DESCRIPTION		DRAWN BY RIZ CHECKED BY KVR		- C421 CD-322993 237 238 01	
		DATE STARTED 24.01.2013 DATE COMPLETED _____		OPRG. DEPT. CTPO ENG. DEPT. AUT-PSAC			
				RIYADH SAUDI ARABIA			





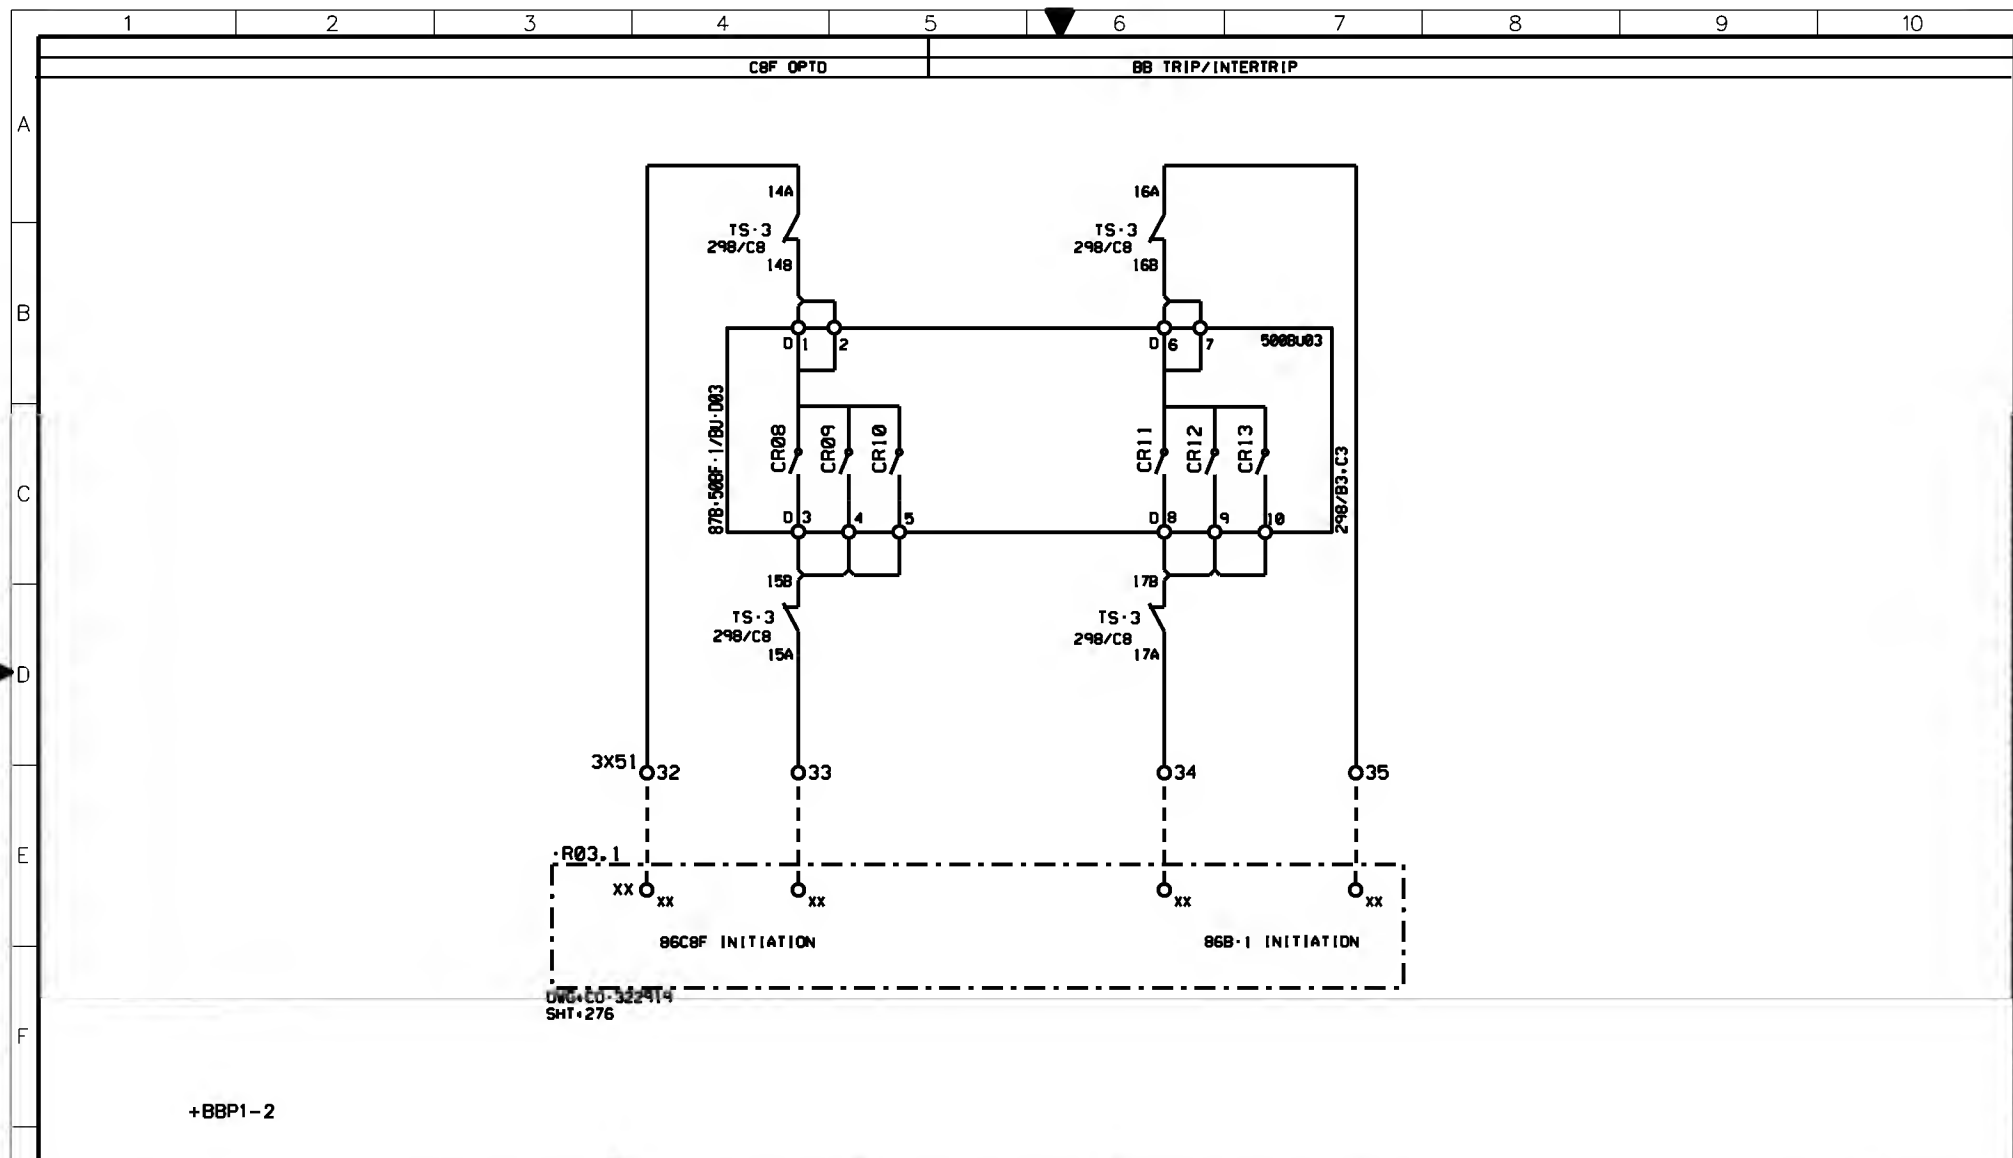

AS-BUILT BY \_\_\_\_\_ DATE \_\_\_\_\_ CONTRACT NO. 11131113/00 JOB ORDER NO. S-13656

0113 49FACTORY ASBUILT

0013 04FOR APPROVAL

REV. NO. DATE DESCRIPTION

DRAWN BY RIZ CHECKED BY KVR

DATE STARTED 24.01.2013 DATE COMPLETED \_\_\_\_\_

OPRG. DEPT. CTPD ENG. DEPT. AUT-PSAC

CBF-1 & BUSBAR PROTN-1 TRIP RELAY CIRCUIT

132KV BUSBAR PROTN.MAIN-1 BU PANEL +BBP1-2

S/S 8709 - 132/13.8KV IN AL-KHARJ CITY

RIYADH SAUDI ARABIA


الشركة الوطنية لنقل الكهرباء


نقل الكهرباء

National Grid sa


INDEX PLANT NO. DRAWING NUMBER SHEET NO. REV. NO.

- C421 CD-322993 239 292 01

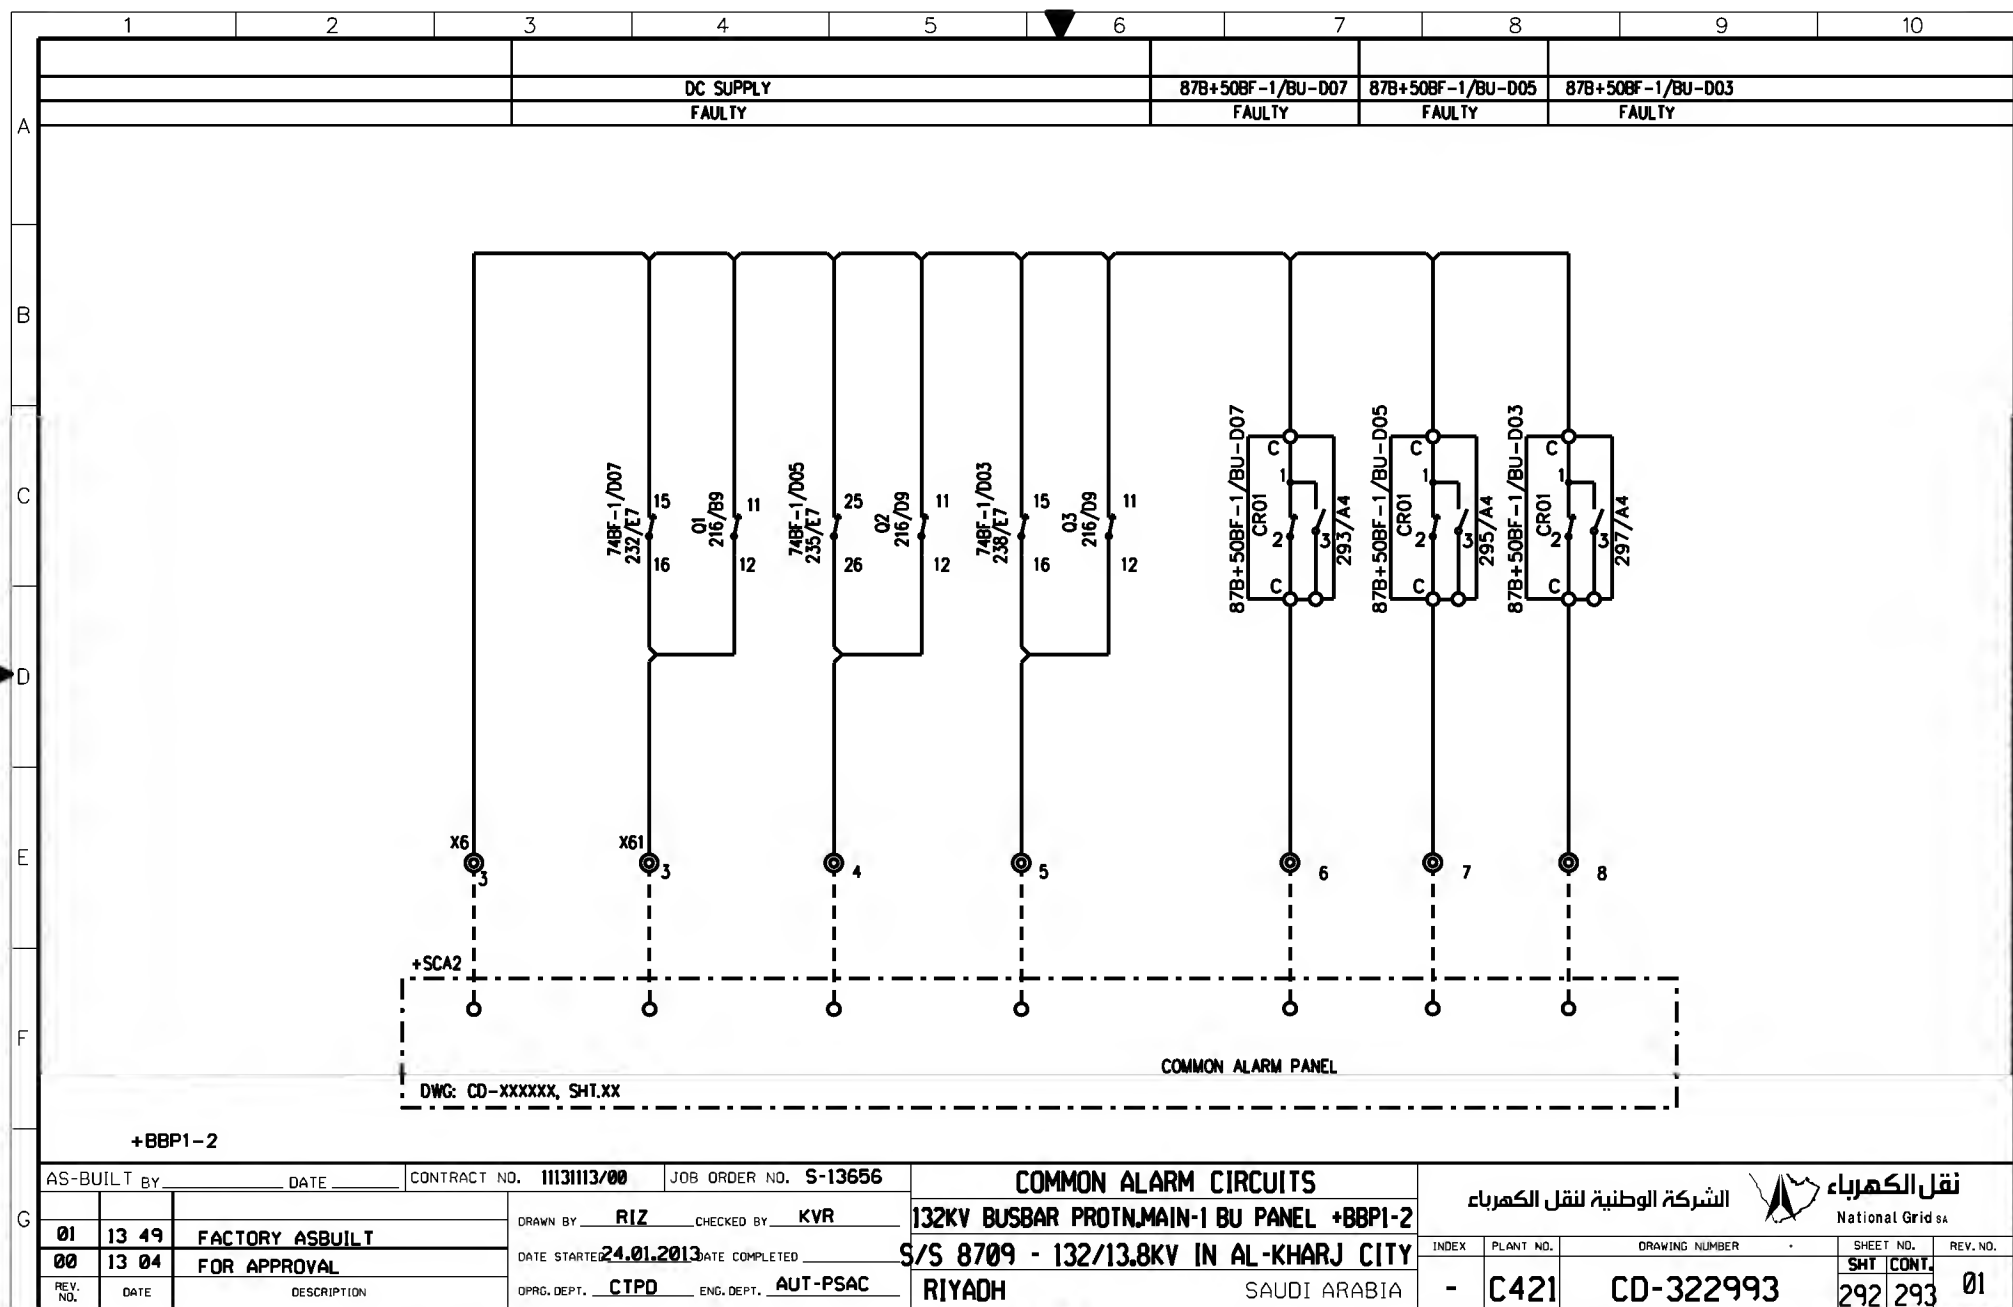


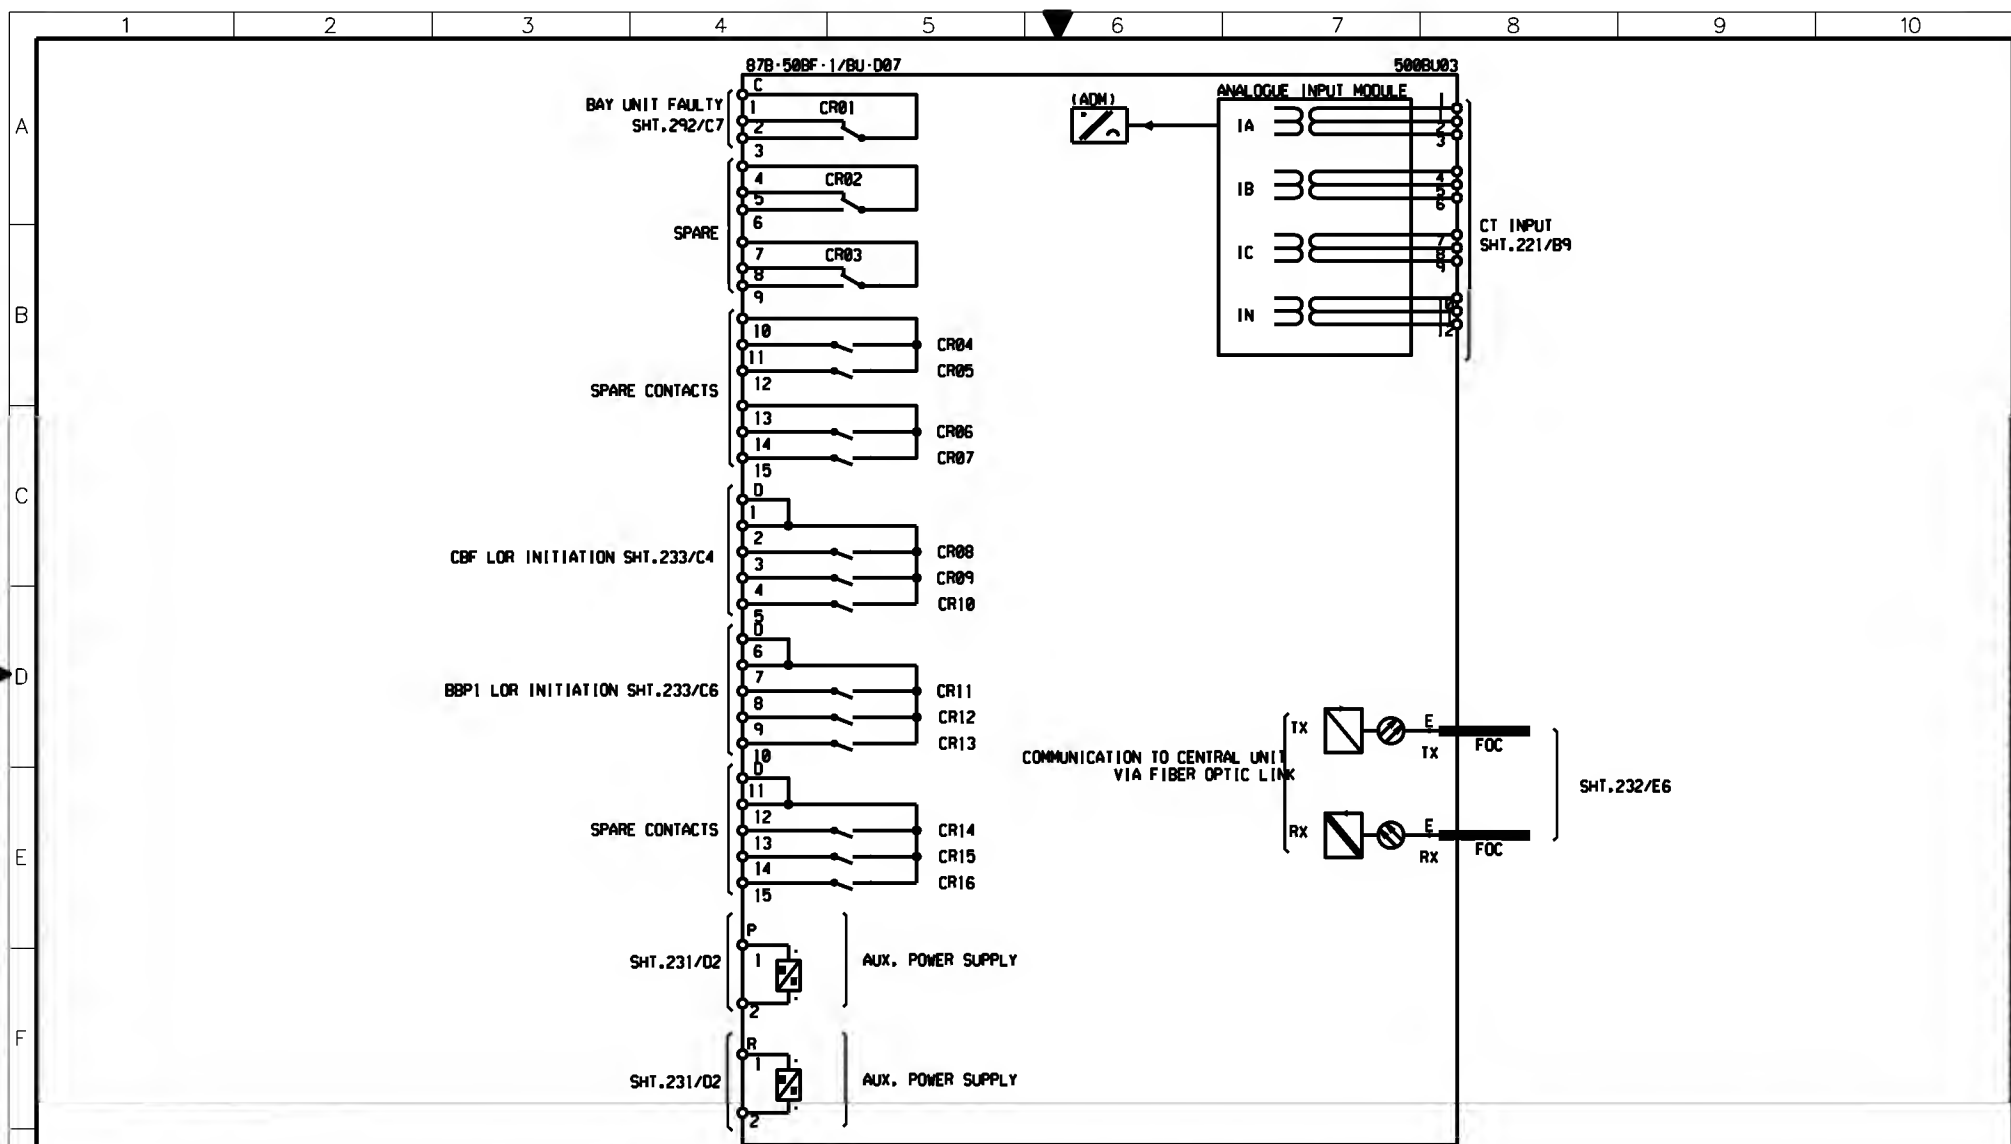

AS-BUILT BY _____ DATE _____			CONTRACT NO. <b>11131113/00</b>		JOB ORDER NO. <b>S-13656</b>		<b>BLOCK REFERENCE-87B+50BF-1/BU-D07</b>			الشركة الوطنية لنقل الكهرباء National Grid sa			
<b>01</b>	<b>13 49</b>	<b>FACTORY ASBUILT</b>	DRAWN BY <b>RIZ</b> CHECKED BY <b>KVR</b>		<b>132KV BUSBAR PROTN.MAIN-1 BU PANEL +BBPI-2</b>		<b>S/S 8709 - 132/13.8KV IN AL-KHARJ CITY</b>			INDEX	PLANT NO.	DRAWING NUMBER	SHEET NO.
<b>00</b>	<b>13 04</b>	<b>FOR APPROVAL</b>	DATE STARTED <b>24.01.2013</b> DATE COMPLETED _____		<b>RIYADH</b>		<b>SAUDI ARABIA</b>			-	<b>C421</b>	<b>CD-322993</b>	<b>293</b>
REV. NO.	DATE	DESCRIPTION	OPRG. DEPT. <b>CTPD</b> ENG. DEPT. <b>AUT-PSAC</b>										CONT.
													<b>294</b>
													<b>01</b>

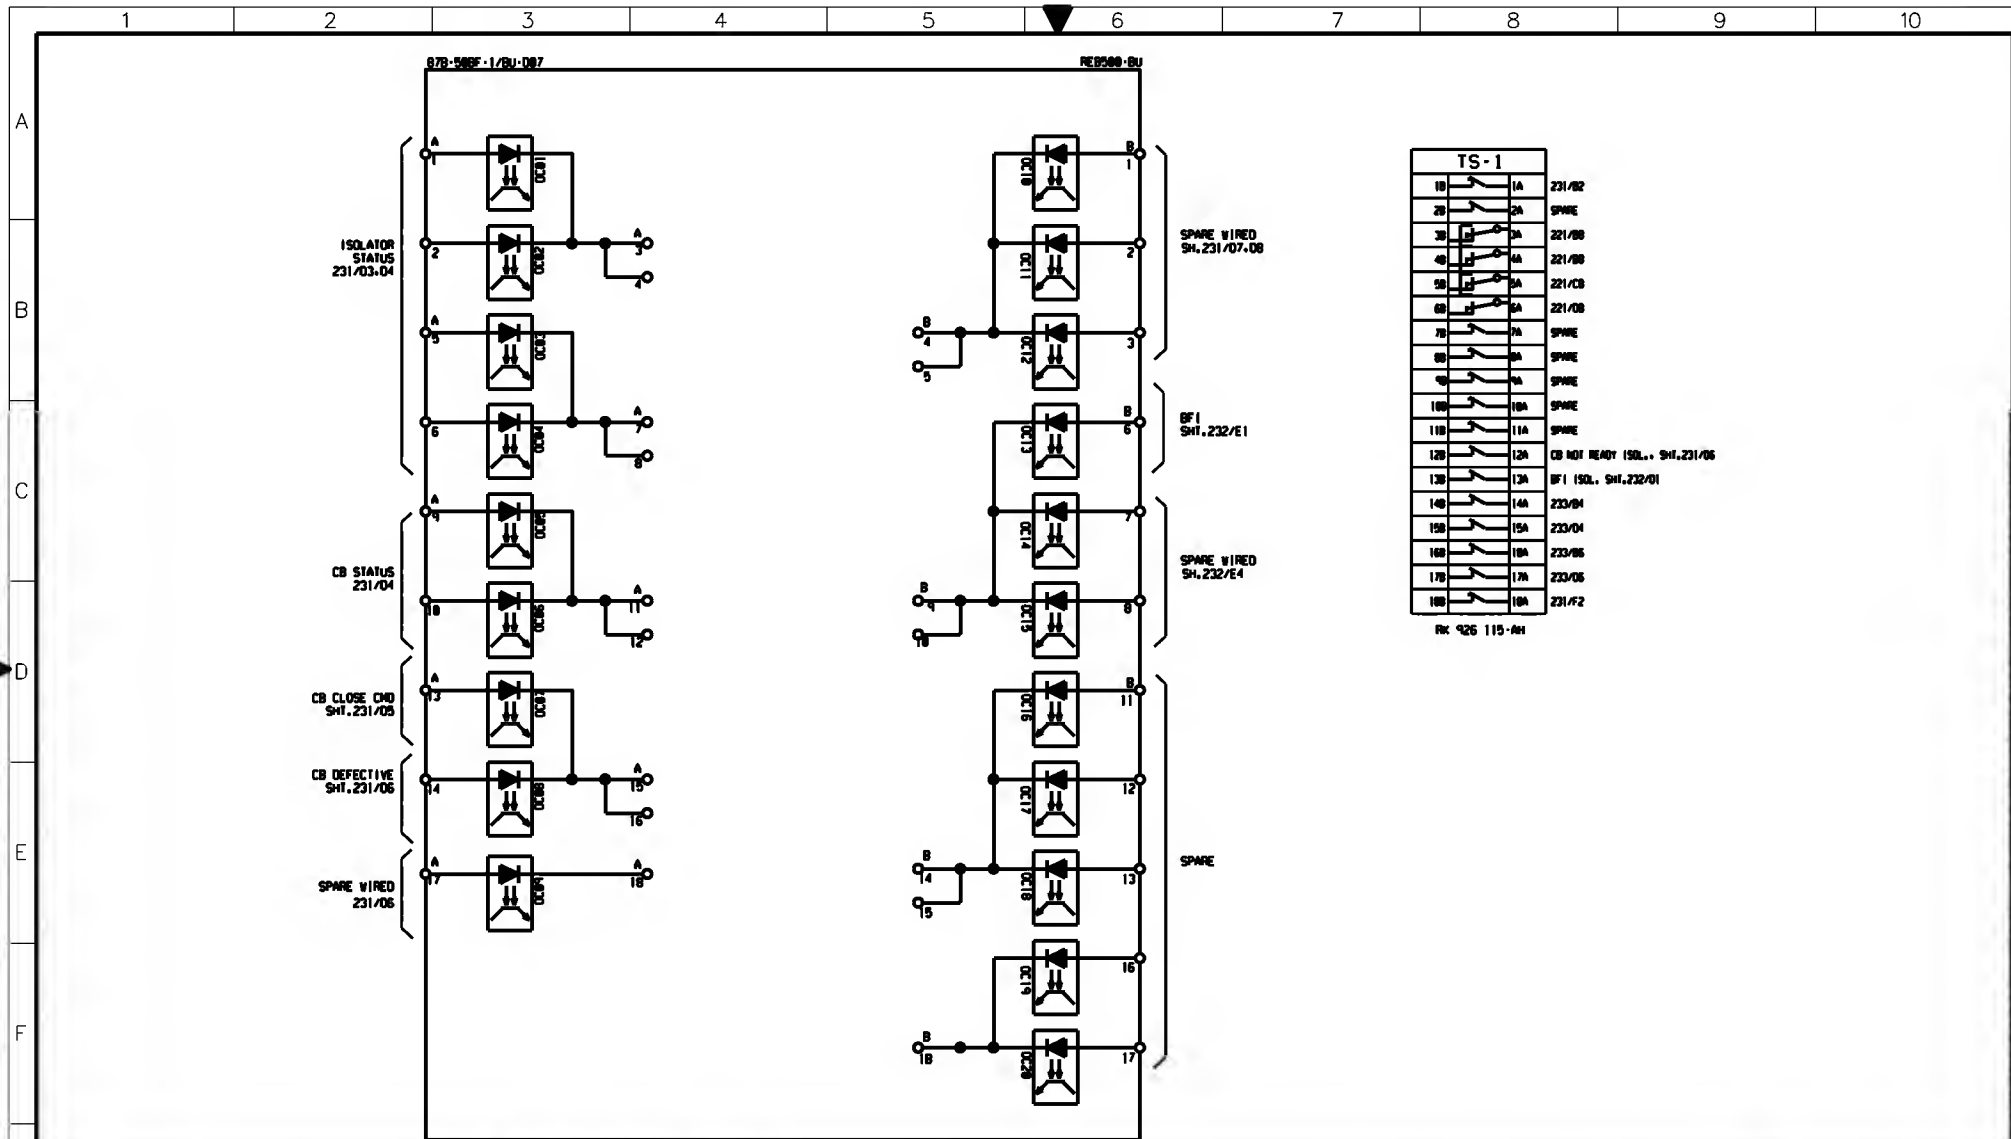


AS-BUILT BY _____ DATE _____		CONTRACT NO. <b>1113113/00</b>	JOB ORDER NO. <b>S-13656</b>	<b>BLOCK REFERENCE-87B+50BF-1/BU-007</b>		الشركة الوطنية لنقل الكهرباء	
DRAWN BY <b>RIZ</b> CHECKED BY <b>KVR</b>		DATE STARTED <b>24.01.2013</b> DATE COMPLETED _____		<b>132KV BUSBAR PROTN.MAIN-1 BU PANEL +B8P1-2</b>		National Grid sa	
DATE STARTED <b>24.01.2013</b> DATE COMPLETED _____		DATE COMPLETED _____		<b>S/S 8709 - 132/13.8KV IN AL-KHARJ CITY</b>		INDEX	PLANT NO.
PRG. DEPT. <b>CTPD</b> ENG. DEPT. <b>AUT-PSAC</b>		DRAWING NUMBER <b>CD-322993</b>		<b>RIYADH SAUDI ARABIA</b>		-	C421
REV. NO.	DATE	DESCRIPTION	SHEET NO. <b>294</b> CONT. <b>295</b>		REV. NO. <b>01</b>		

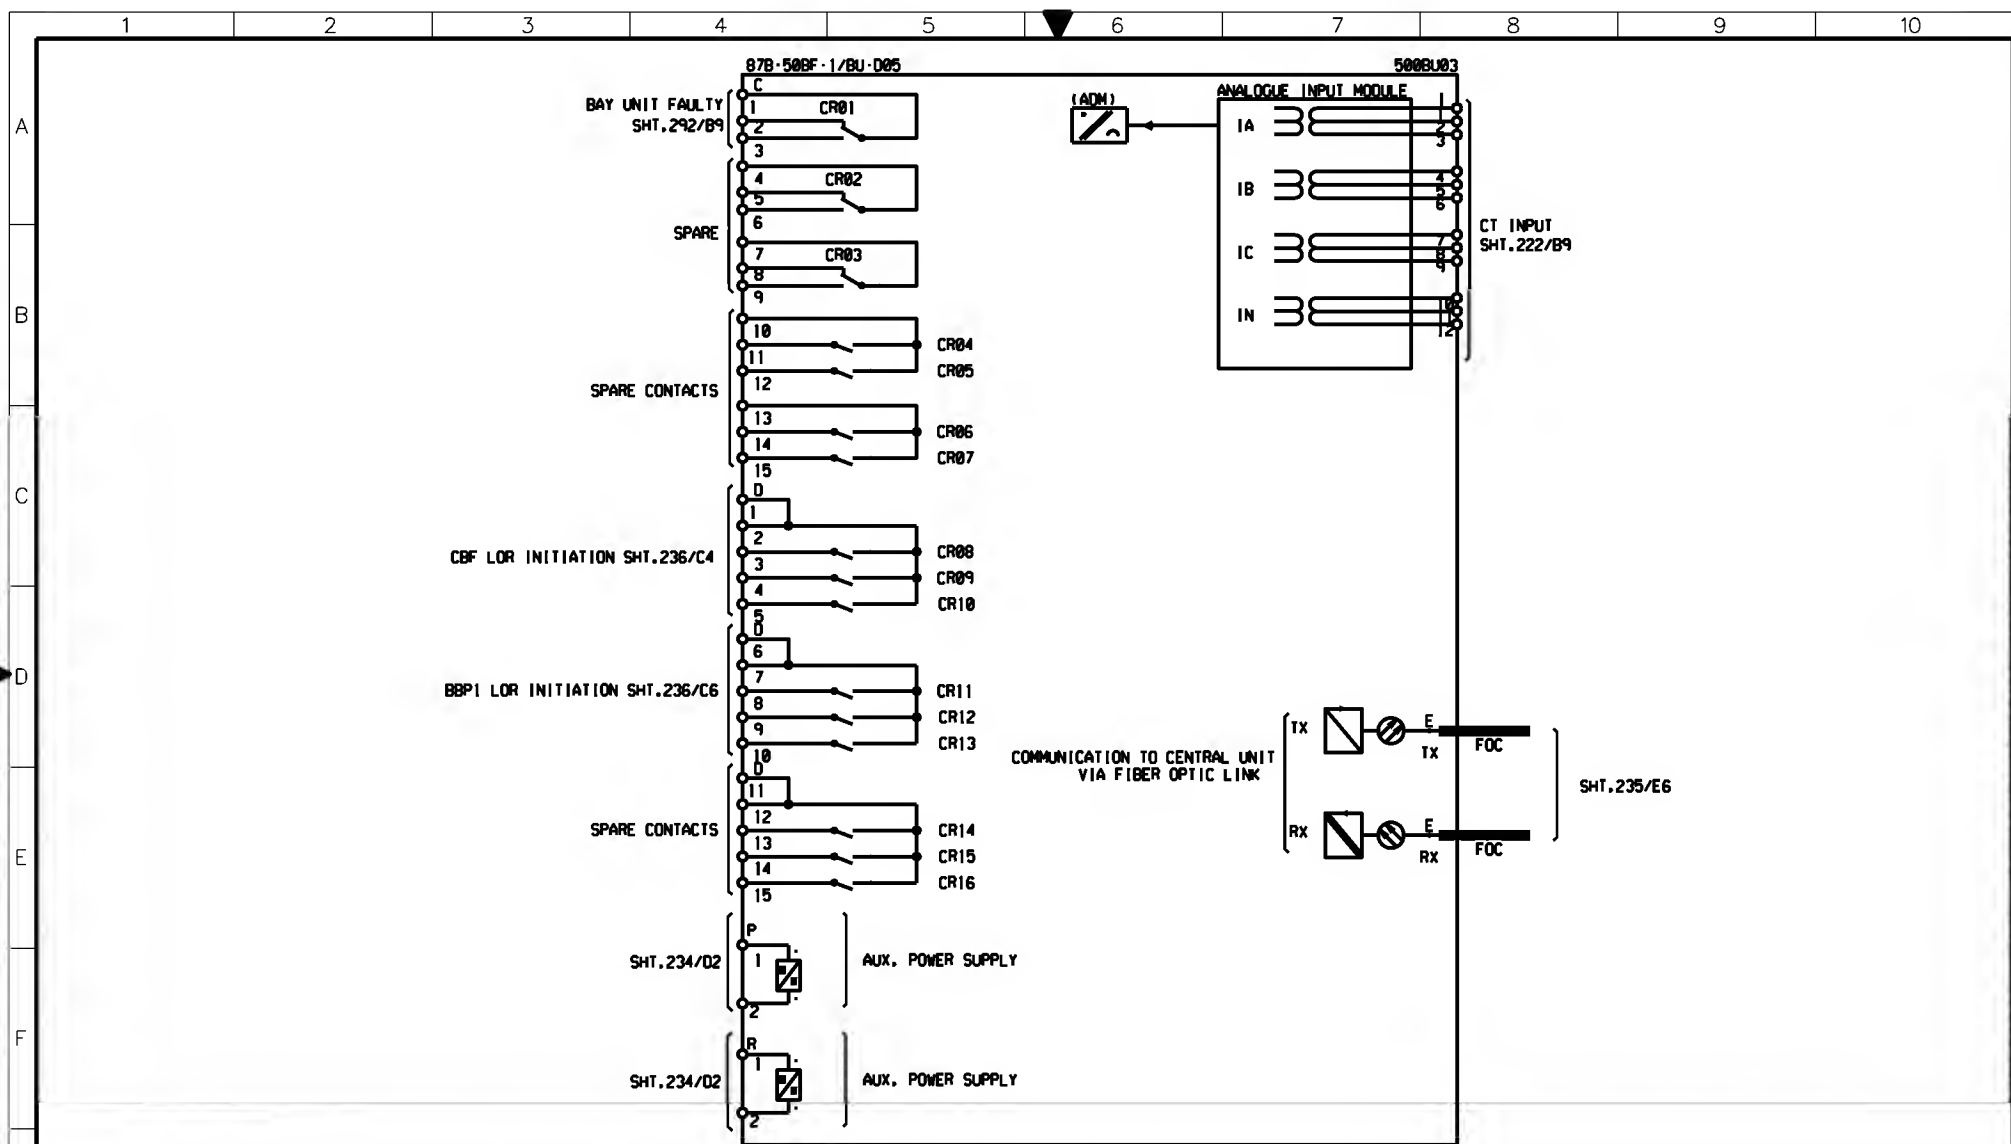

AS-BUILT BY _____ DATE _____			CONTRACT NO. 11131113/00		JOB ORDER NO. S-13656		BLOCK REFERENCE-87B+50BF-2/BU-D05			نقل الكهرباء الشركة الوطنية لنقل الكهرباء National Grid sa				
			DRAWN BY RIZ CHECKED BY KVR			132KV BUSBAR PROTN.MAIN-1 BU PANEL +BBP1-2								
01 13 49 FACTORY ASBUILT			DATE STARTED 24.01.2013 DATE COMPLETED _____			S/S 8709 - 132/13.8KV IN AL-KHARJ CITY								
00 13 04 FOR APPROVAL			OPRG. DEPT. CTPD ENG. DEPT. AUT-PSAC			RIYADH SAUDI ARABIA								
REV. NO. _____ DATE _____ DESCRIPTION _____														

INDEX	PLANT NO.	DRAWING NUMBER	SHEET NO.	REV. NO.
-	C421	CD-322993	SHT CONT. 295 296	01

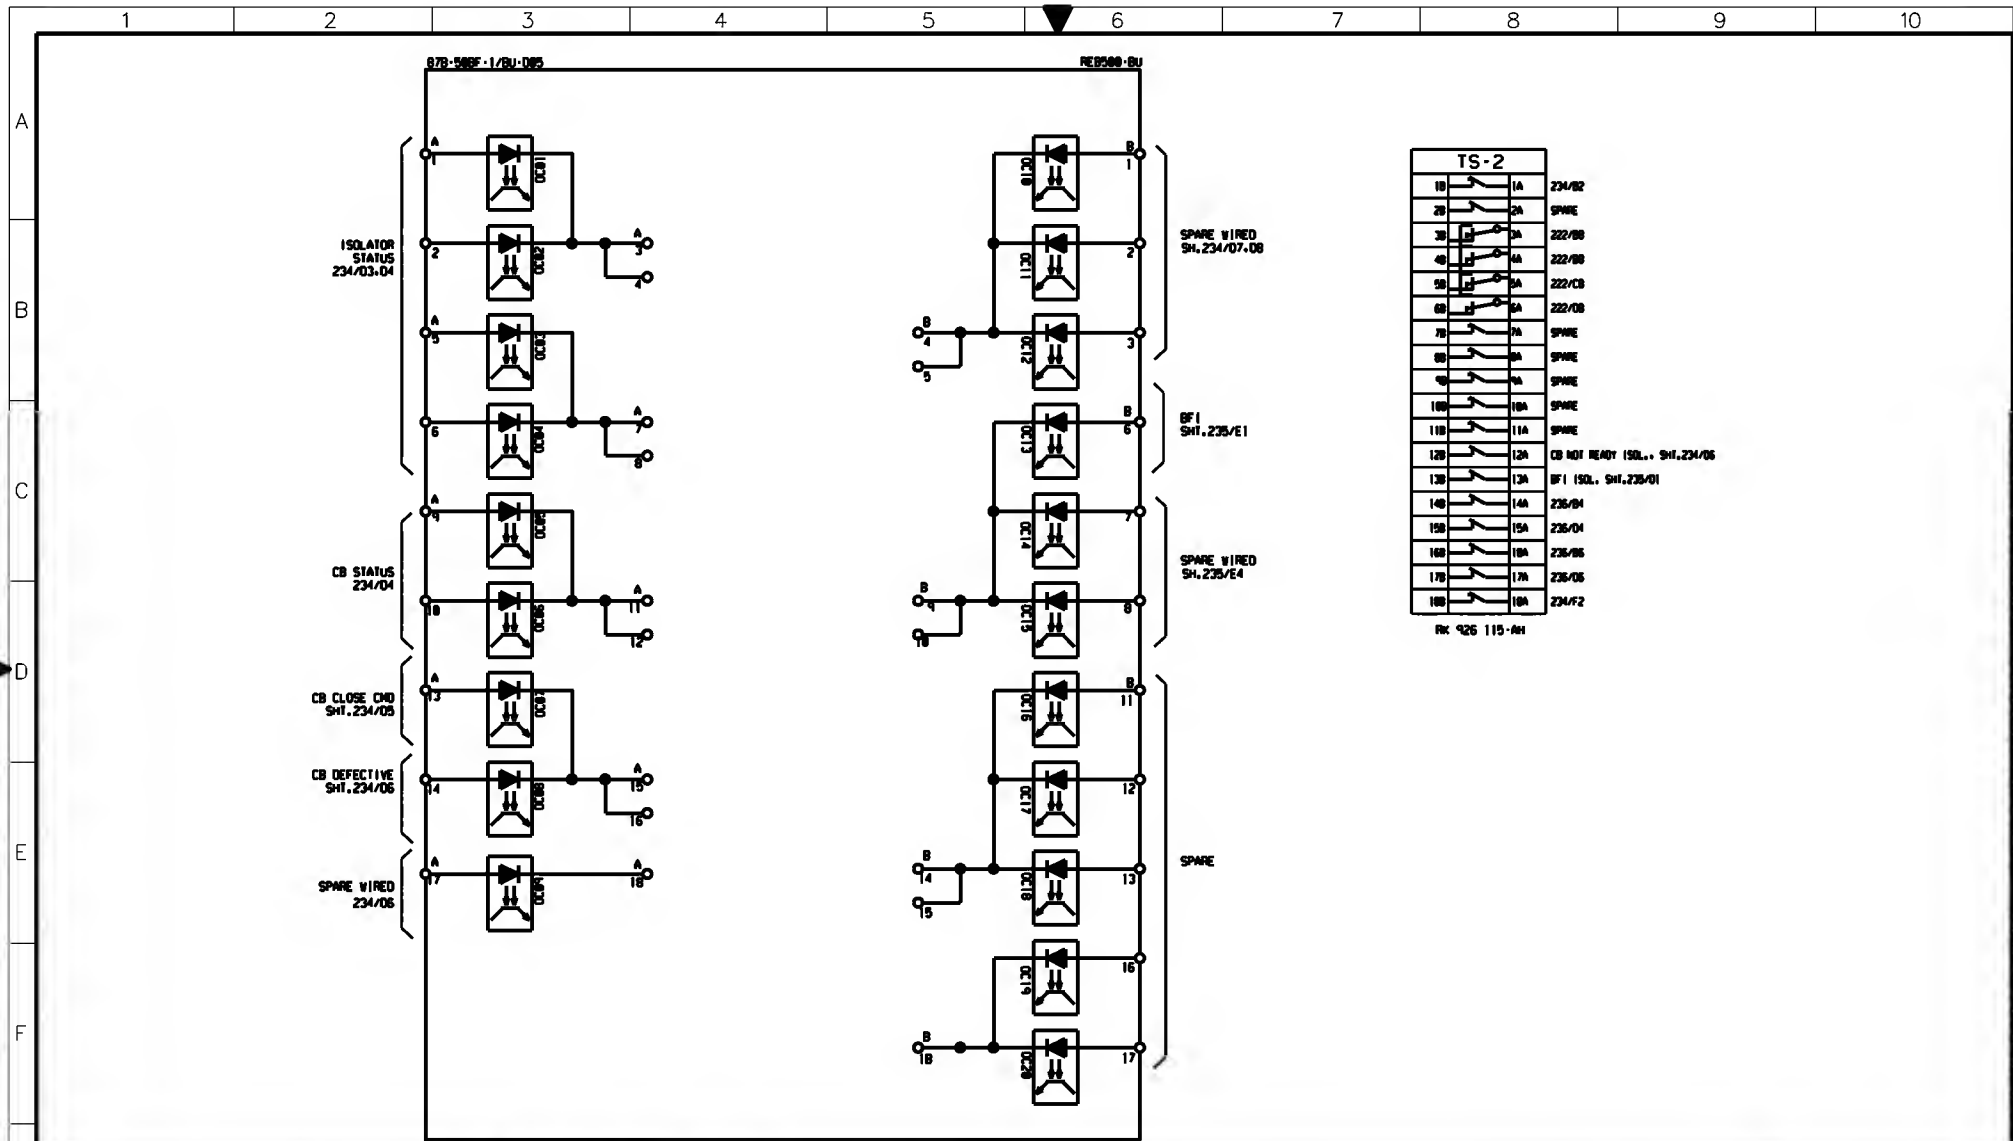

AS-BUILT BY \_\_\_\_\_ DATE \_\_\_\_\_ CONTRACT NO. **1113113/00** JOB ORDER NO. **S-13656**

01	13 49	FACTORY ASBUILT
00	13 04	FOR APPROVAL
REV. NO.	DATE	DESCRIPTION

DRAWN BY **RIZ** CHECKED BY **KVR**

DATE STARTED **24.01.2013** DATE COMPLETED \_\_\_\_\_

OPRG. DEPT. **CTPD** ENG. DEPT. **AUT-PSAC**

**BLOCK REFERENCE-878+50BF-2/BU-005**

**132KV BUSBAR PROTN.MAIN-1 BU PANEL +BBP1-2**


**S/S 8709 - 132/13.8KV IN AL-KHARJ CITY**

**RIYADH SAUDI ARABIA**

الشركة الوطنية لنقل الكهرباء




INDEX	PLANT NO.	DRAWING NUMBER	SHEET NO.	REV. NO.
-	C421	CD-322993	296 297	01

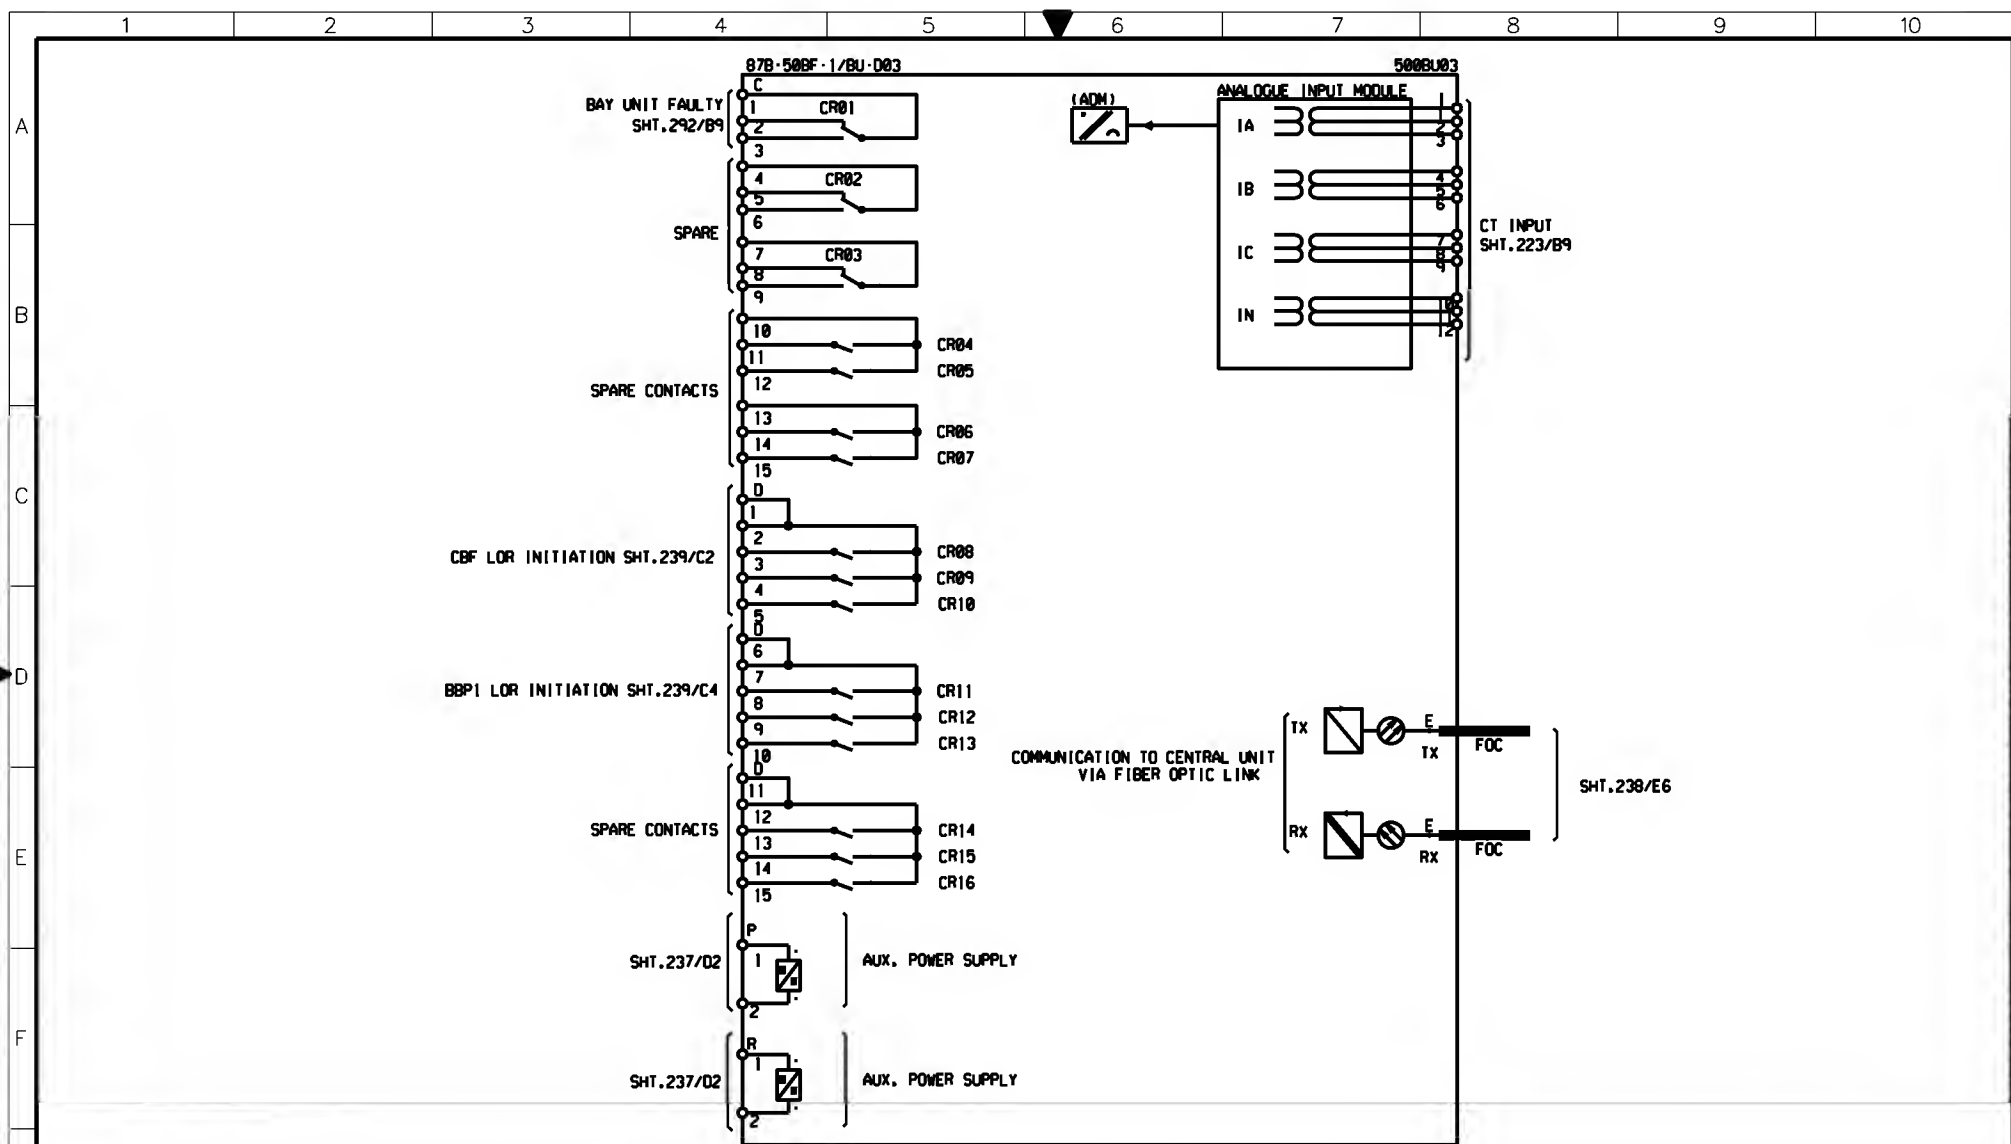

AS-BUILT BY _____ DATE _____			CONTRACT NO. <b>11131113/00</b>		JOB ORDER NO. <b>S-13656</b>		<b>BLOCK REFERENCE-87B+50BF-1/BU-D03</b>			الشركة الوطنية لنقل الكهرباء National Grid sa			
<b>01</b>	<b>13 49</b>	<b>FACTORY ASBUILT</b>	DRAWN BY <b>RIZ</b> CHECKED BY <b>KVR</b>		DATE STARTED <b>24.01.2013</b> DATE COMPLETED _____		<b>132KV BUSBAR PROTN.MAIN-1 BU PANEL +BBPI-2</b>			INDEX	PLANT NO.	DRAWING NUMBER	SHEET NO.
<b>00</b>	<b>13 04</b>	<b>FOR APPROVAL</b>	PRG. DEPT. <b>CTPD</b> ENG. DEPT. <b>AUT-PSAC</b>		<b>S/S 8709 - 132/13.8KV IN AL-KHARJ CITY</b>		<b>RIYADH SAUDI ARABIA</b>			-	<b>C421</b>	<b>CD-322993</b>	<b>297</b>
REV. NO.	DATE	DESCRIPTION											CONT.
													<b>298</b>
													<b>01</b>



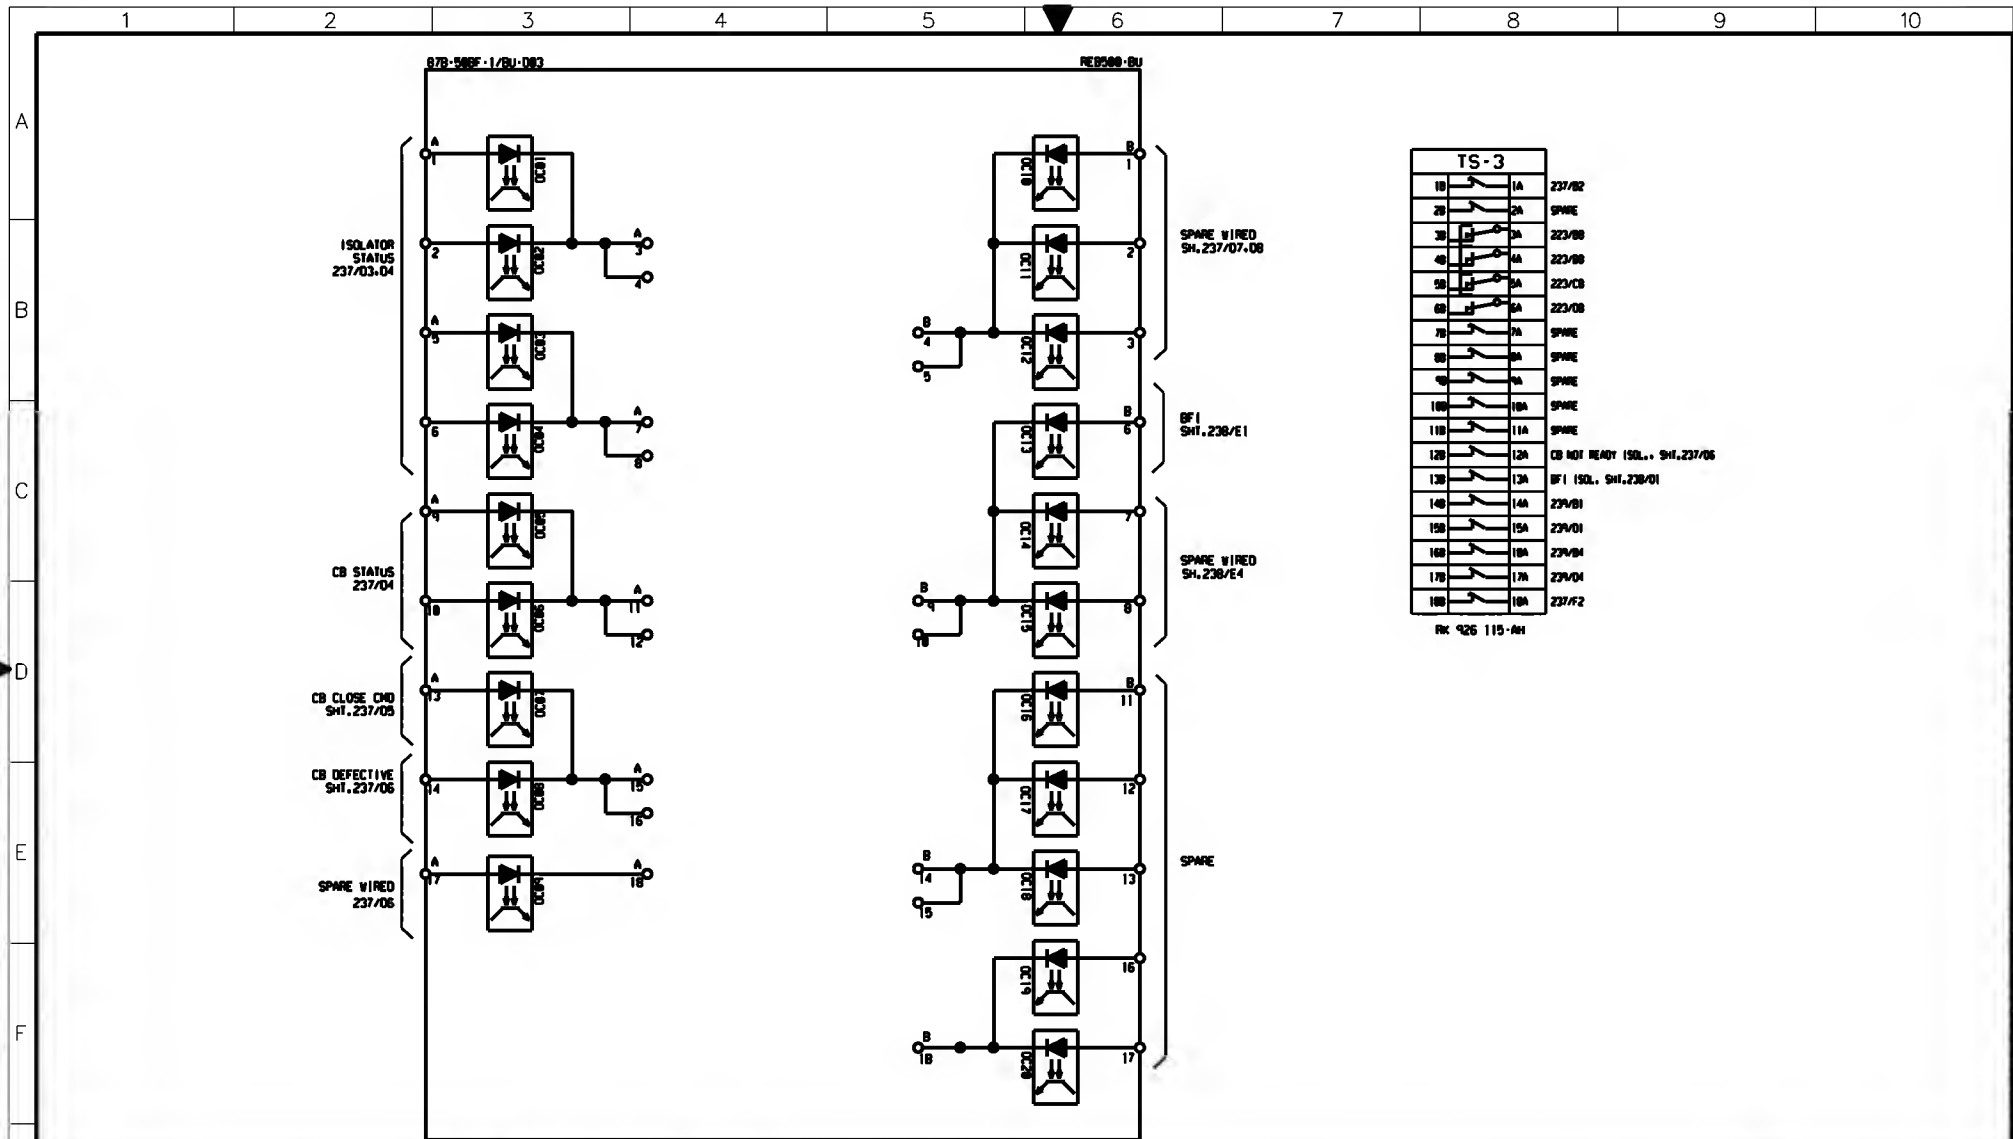

AS-BUILT BY \_\_\_\_\_ DATE \_\_\_\_\_ CONTRACT NO. **1113113/00** JOB ORDER NO. **S-13656**

01	13 49	FACTORY ASBUILT
00	13 04	FOR APPROVAL
REV. NO.	DATE	DESCRIPTION

DRAWN BY **RIZ** CHECKED BY **KVR**

DATE STARTED **24.01.2013** DATE COMPLETED \_\_\_\_\_

OPRG. DEPT. **CTPD** ENG. DEPT. **AUT-PSAC**

**BLOCK REFERENCE-878+508F-1/BU-003**

**132KV BUSBAR PROT.N.MAIN-1 BU PANEL +BBP1-2**

**S/S 8709 - 132/13.8KV IN AL-KHARJ CITY**

**RIYADH SAUDI ARABIA**

الشركة الوطنية لنقل الكهرباء			 نقل الكهرباء National Grid SA					
DEX	PLANT NO.	DRAWING NUMBER	SHEET NO.	REV. NO.				
-	C421	CD-322993	<table><tr><td>SHT</td><td>CONT.</td></tr><tr><td>298</td><td>301</td></tr></table>	SHT	CONT.	298	301	01
SHT	CONT.							
298	301							

1

2

3

4

5

6

7

8

9

10

A

REFERENCE

1X1 CT CKT.

221/B7

221/B7

221/C7

221/C7

221/D7

221/D7

SPARE

1

2

3

4

5

6

7

8

9

10

B

REFERENCE

1X51 CON & PROTIN CKTS.

231/A3

231/A5

231/A6

231/A6

232/A1

232/A2

232/A2

232/A3

232/A4

232/A4

231/C3

231/C3

231/C4

231/C4

231/C4

231/C5

231/C5

231/C8

231/C8

231/C7

231/C8

231/C8

232/D1

232/C1

232/C3

232/D4

232/D5

232/B6

232/F6

232/B6

232/F6

233/E4

233/E4

233/E6

233/E7

SPARE

SPARE

SPARE

SPARE

231

231

AS-BUILT BY \_\_\_\_\_ DATE \_\_\_\_\_ CONTRACT NO. 11131113/00 JOB ORDER NO. S-13656

01	13 49	FACTORY ASBUILT
00	13 04	FOR APPROVAL
REV. NO.	DATE	DESCRIPTION

DRAWN BY RIZ CHECKED BY KVR  
DATE STARTED 24.01.2013 DATE COMPLETED \_\_\_\_\_  
PRG. DEPT. CTPD ENG. DEPT. AUT-PSAC

TERMINAL BLOCKS PANEL +BB1-2  
132KV BUSBAR PROTIN MAIN-1 BU PANEL +BBP1-2  
S/S 8709 - 132/13.8KV IN AL-KHARJ CITY  
RIYADH SAUDI ARABIA

الشركة الوطنية لنقل الكهرباء		نقل الكهرباء		National Grid sa	
INDEX	PLANT NO.	DRAWING NUMBER	SHEET NO.	REV. NO.	
-	C421	CD-322993	301 NIL	01	